



計画図全体図

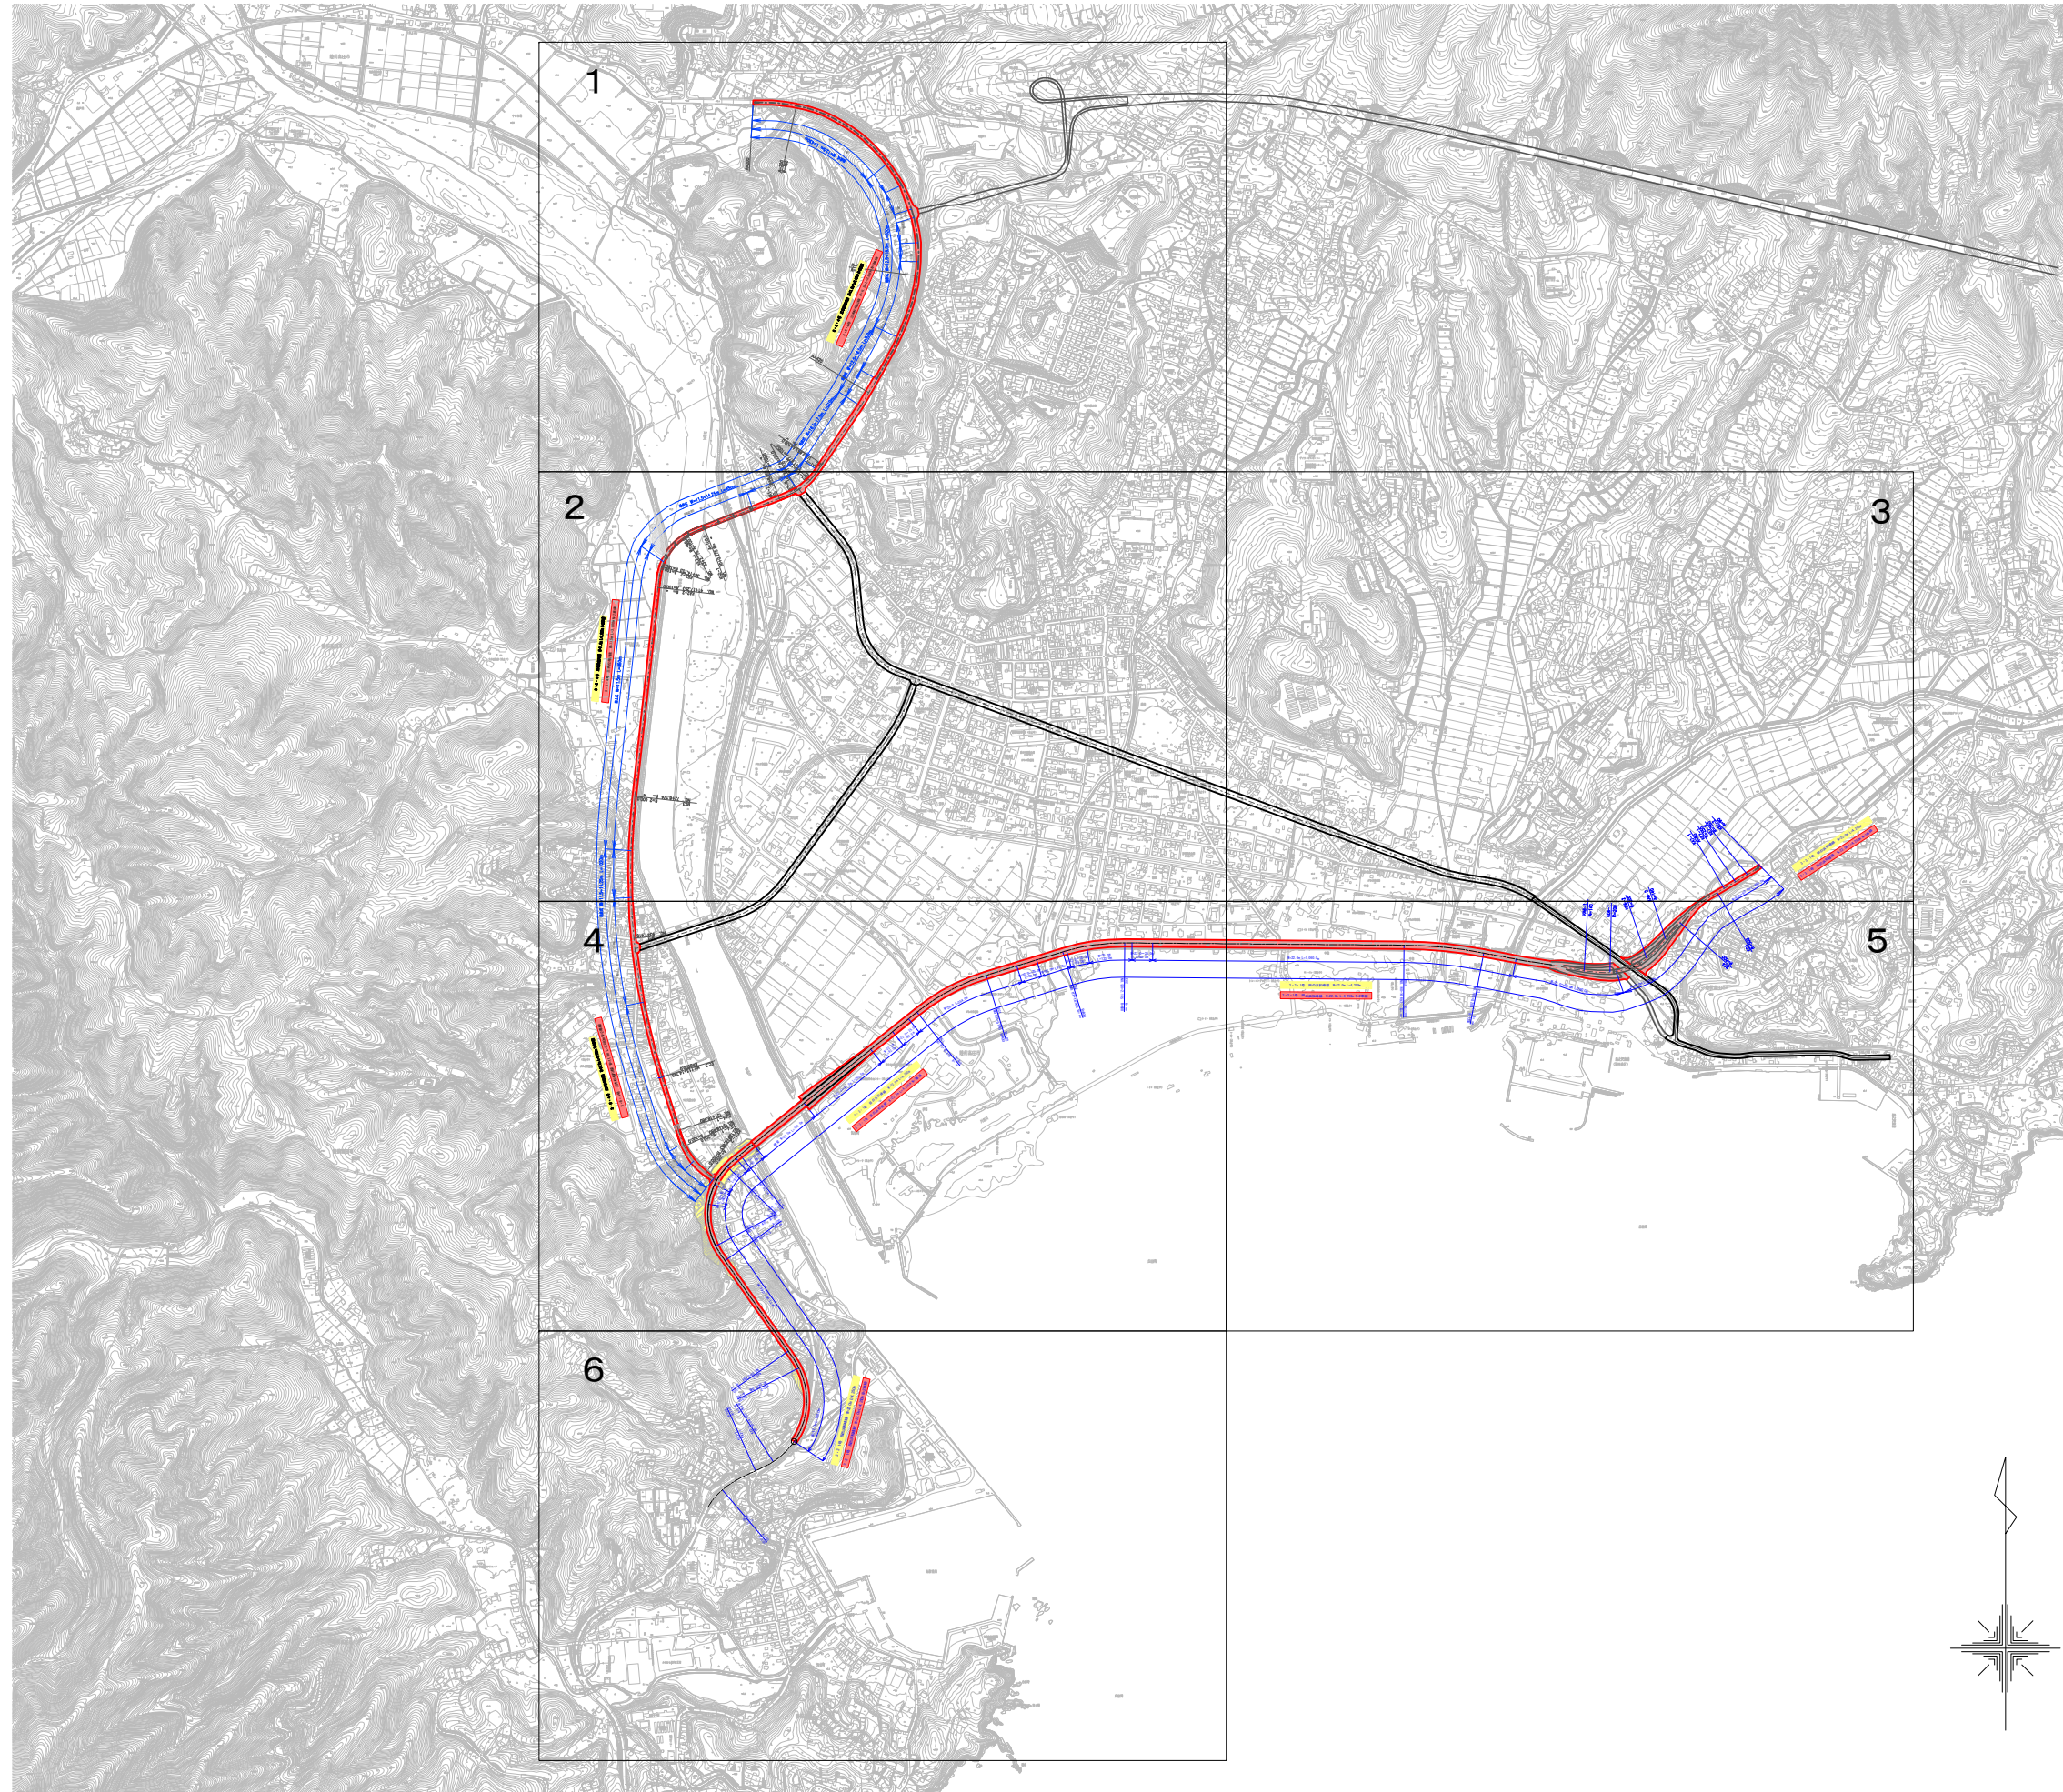


凡例	


S=1:10,000

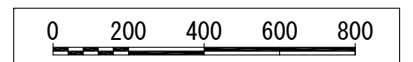


計画図(1) S=1/2, 500

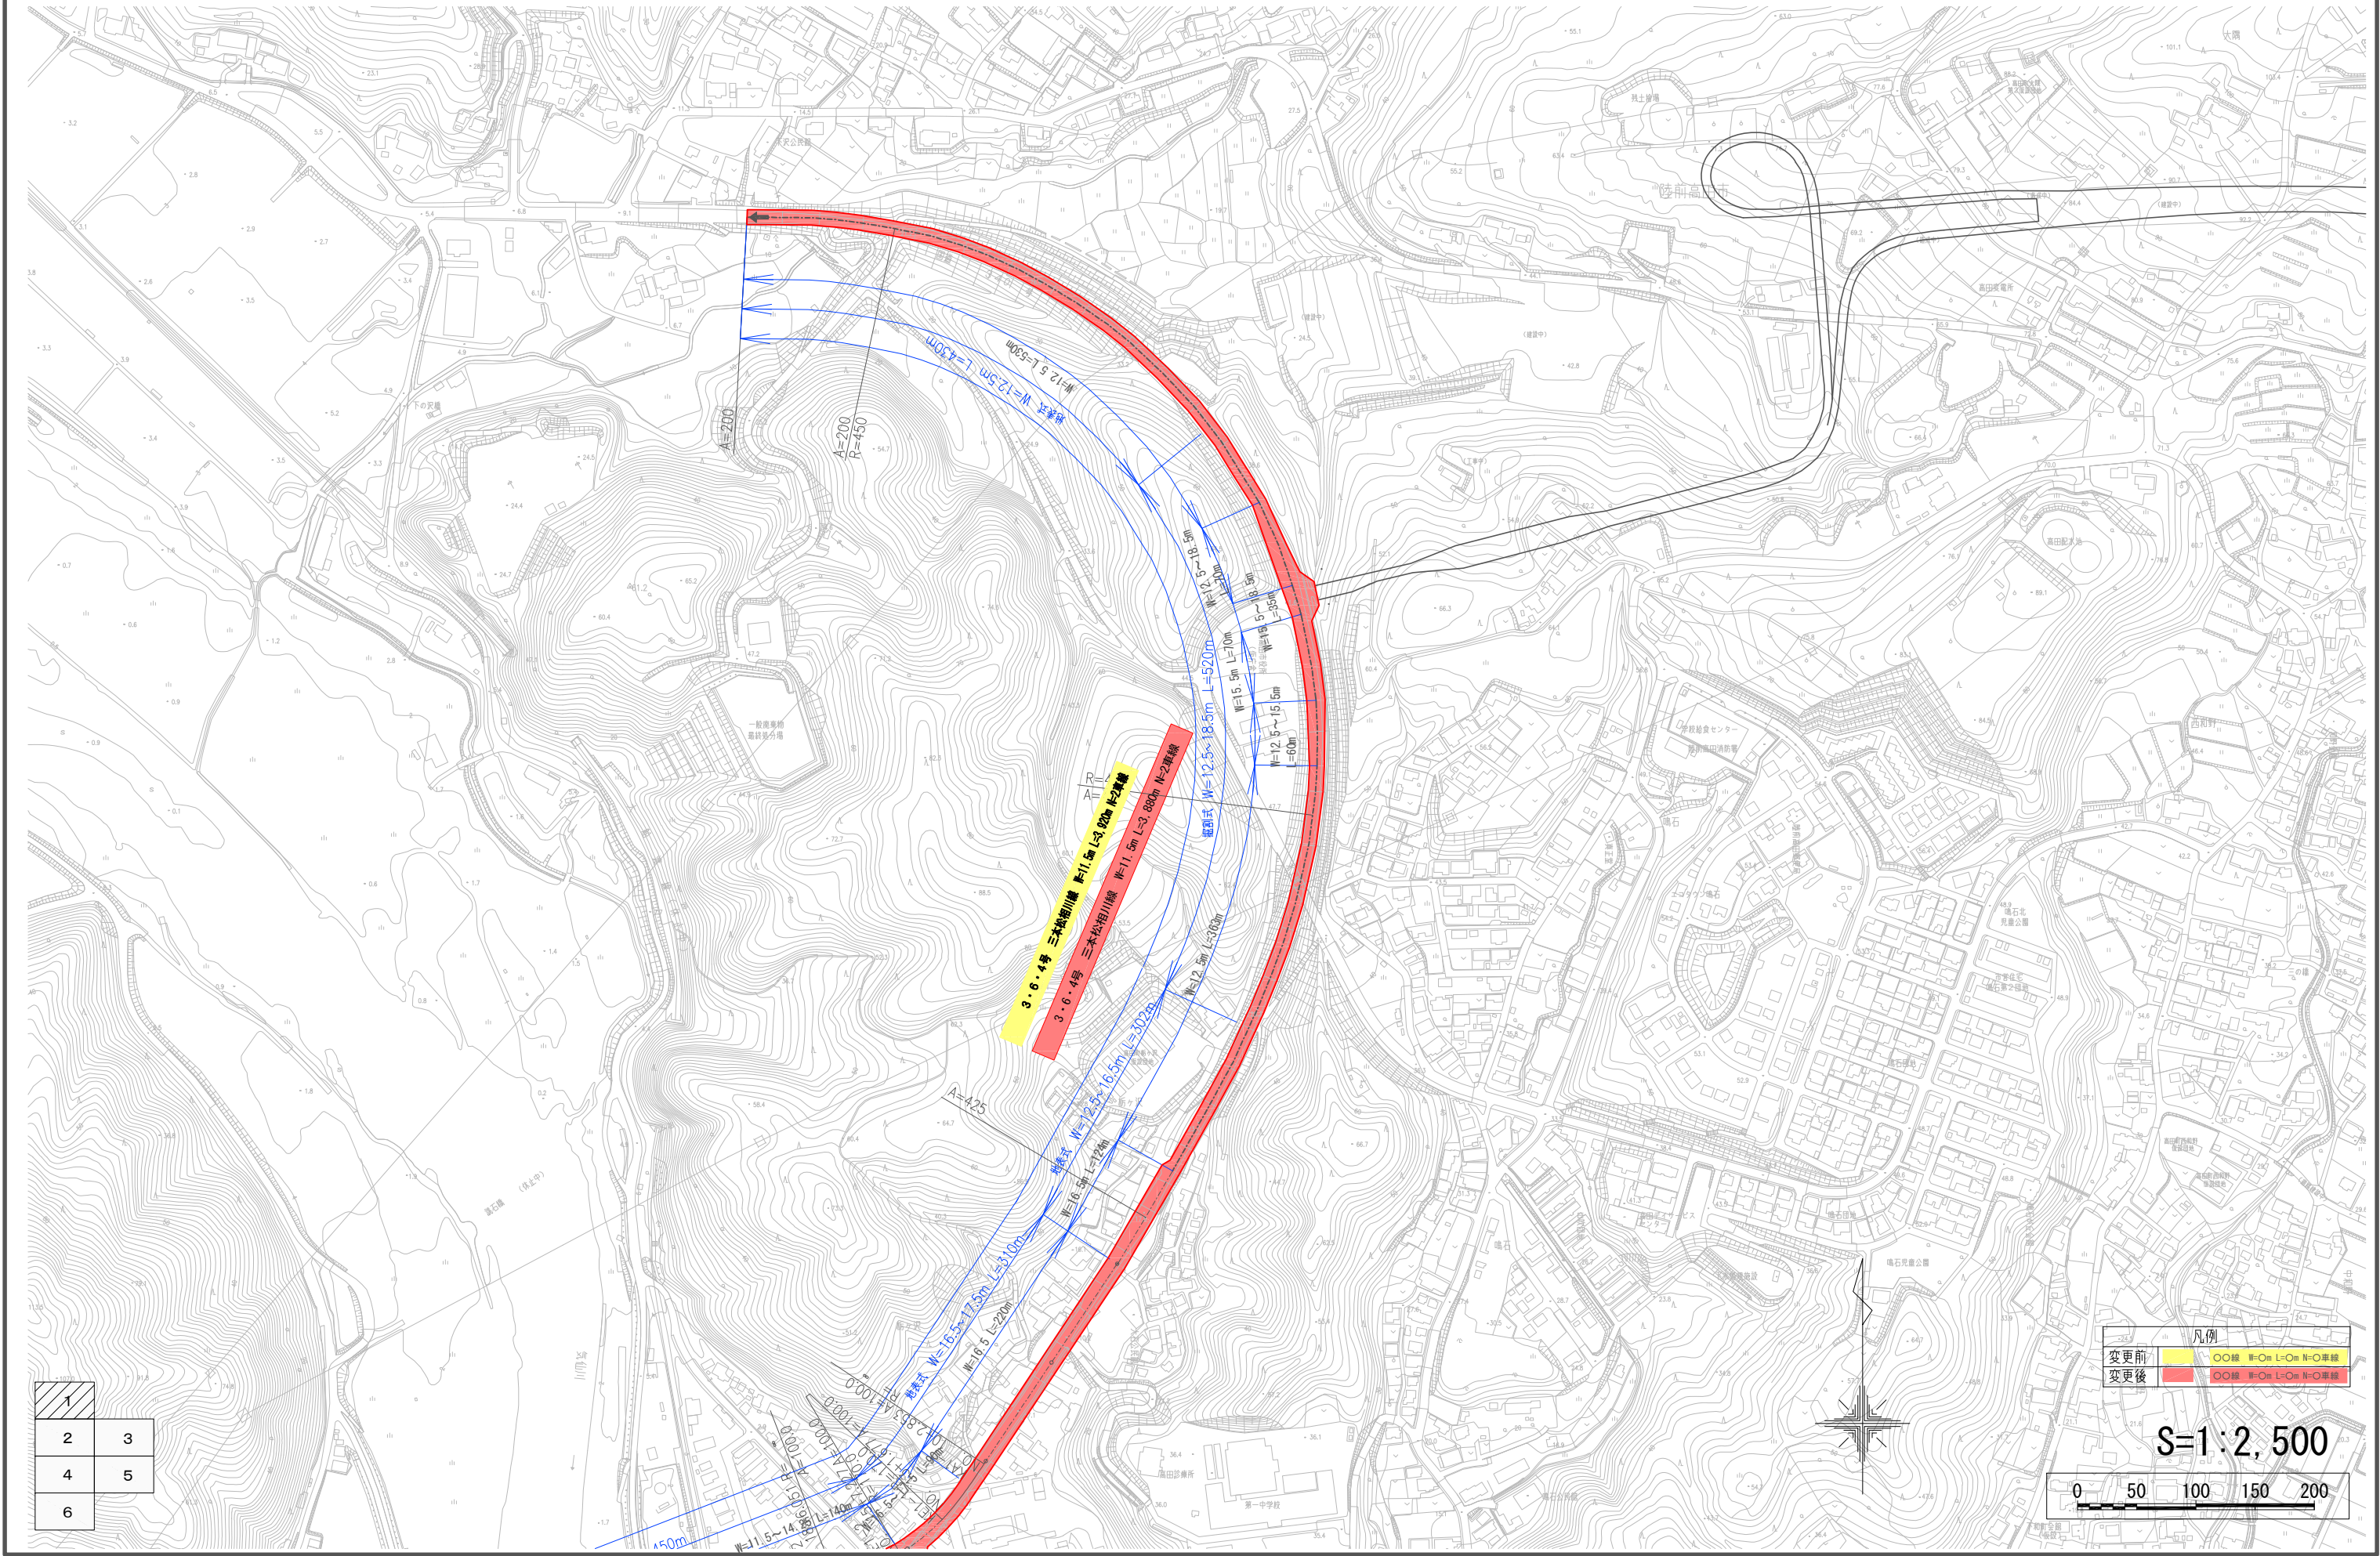


計画図(2) S=1/2, 500

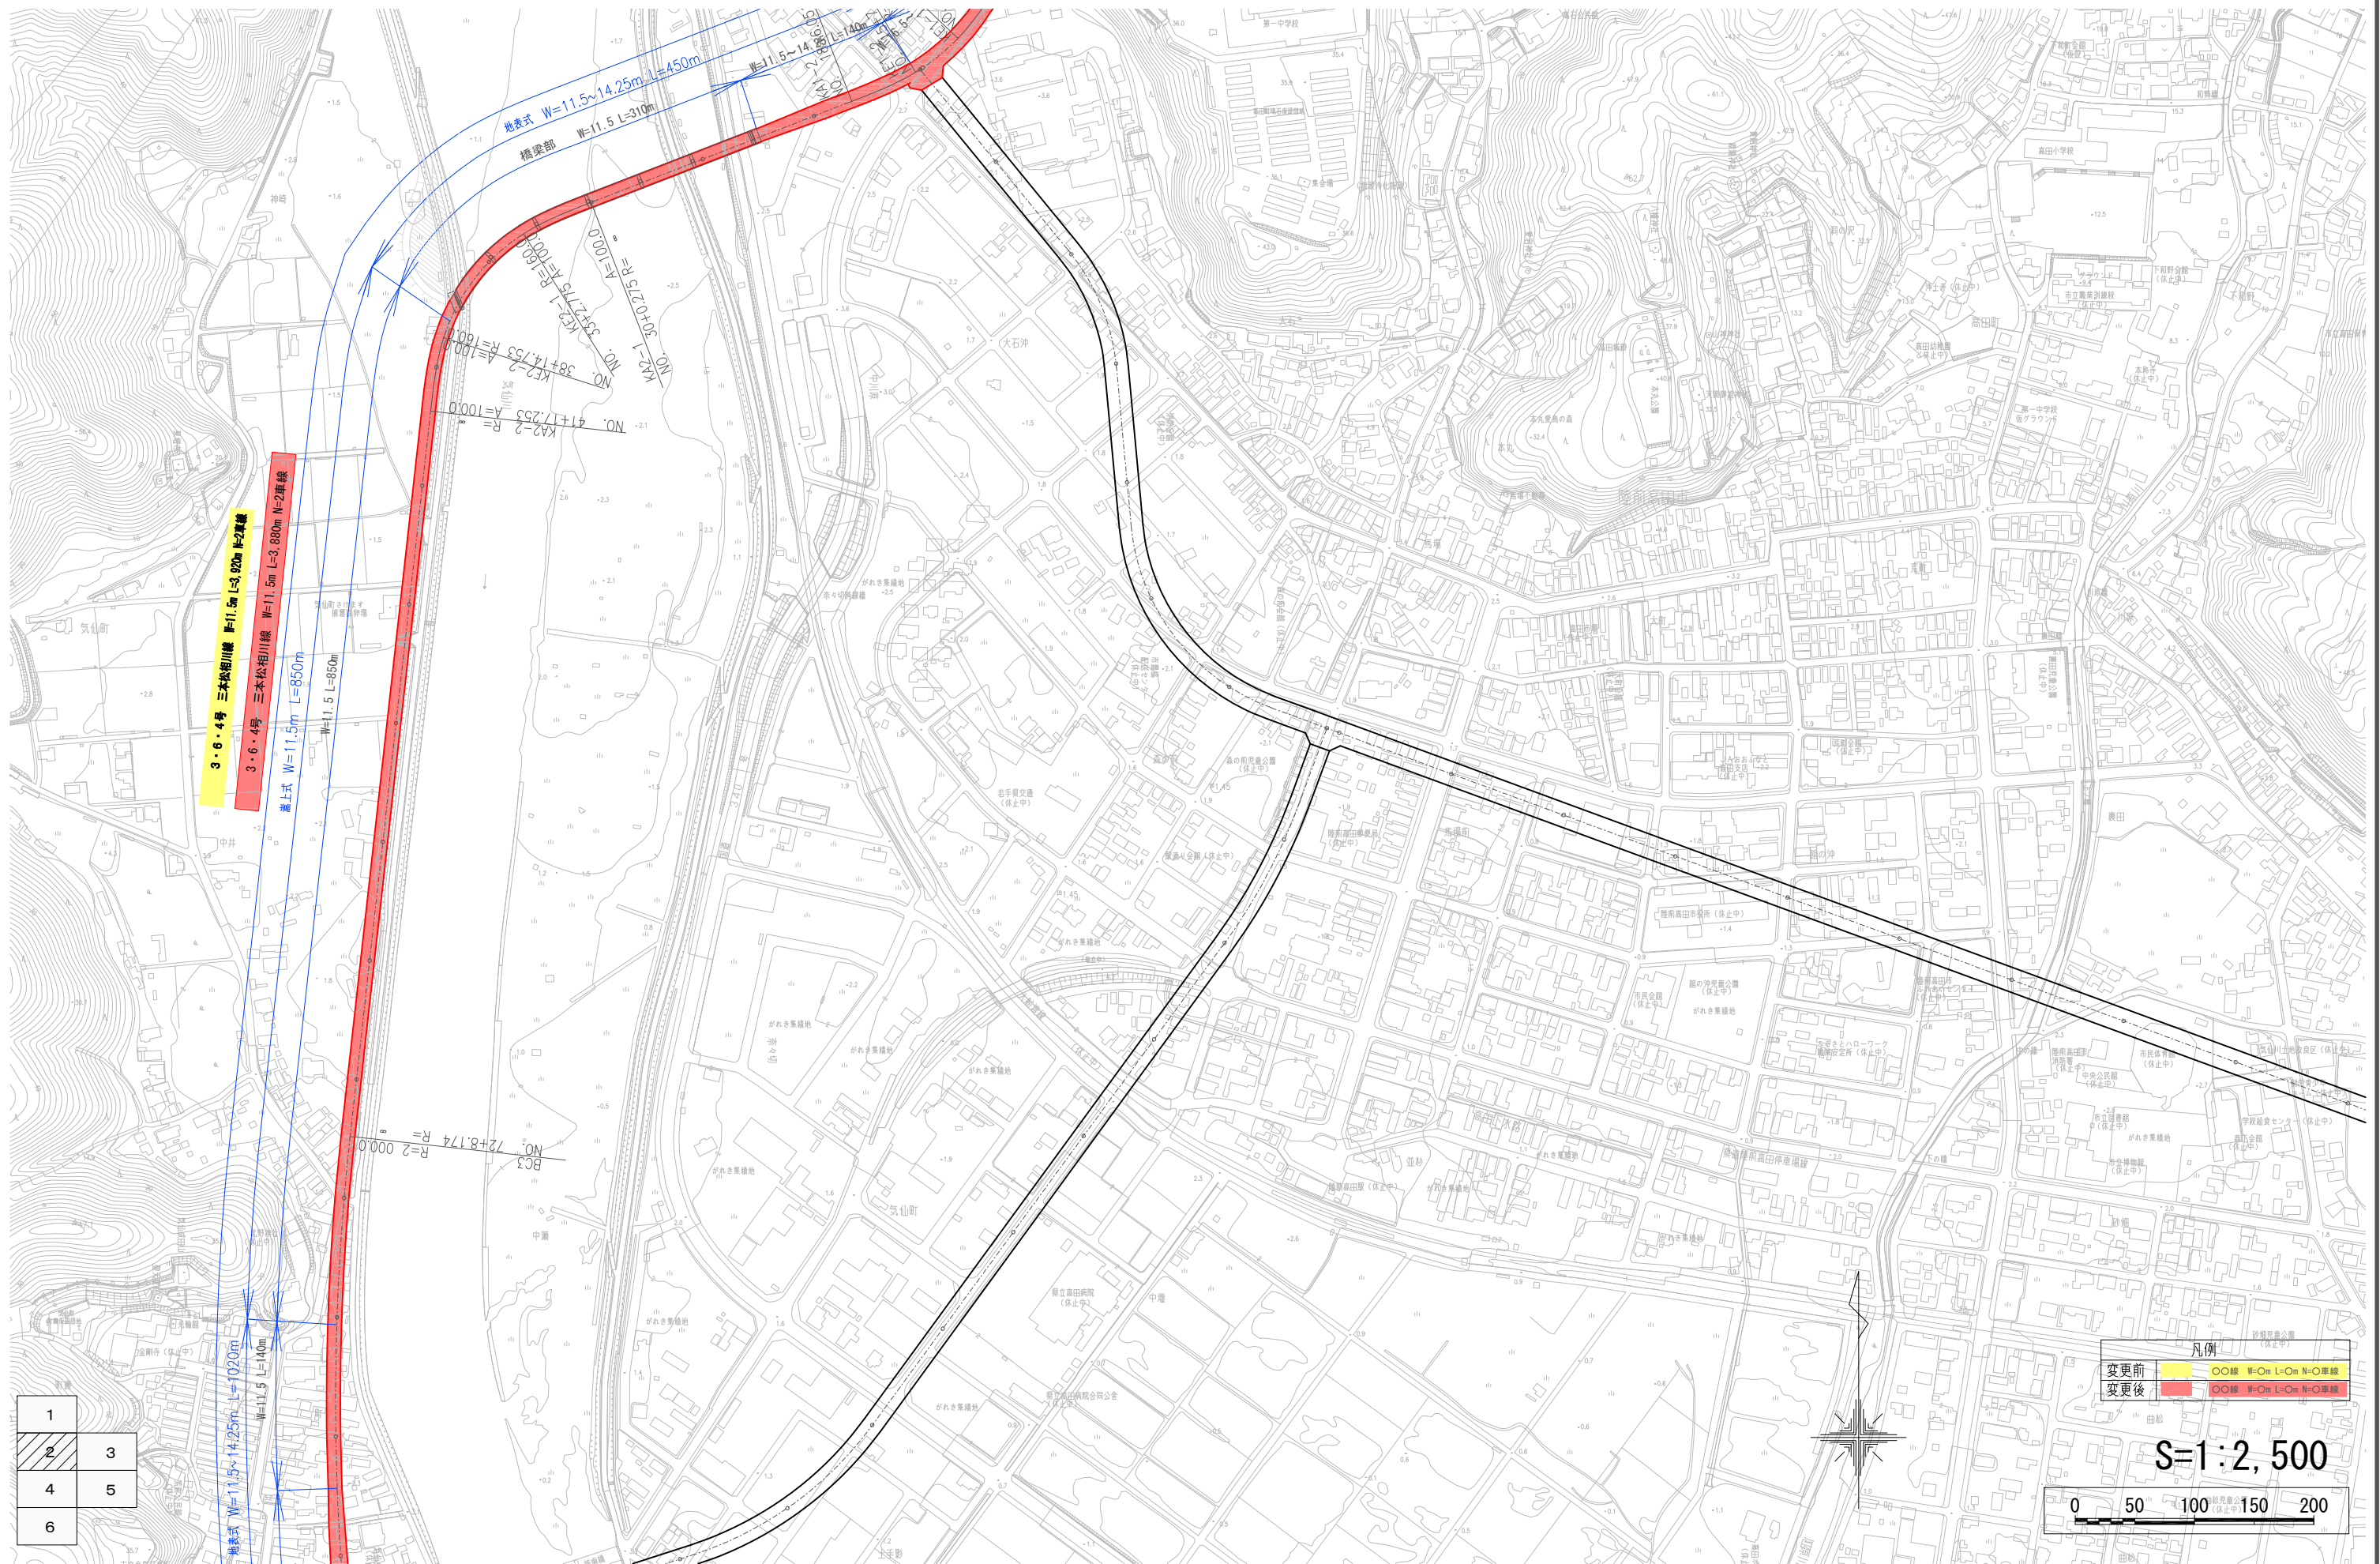

計画図(3) $S=1/2, 500$

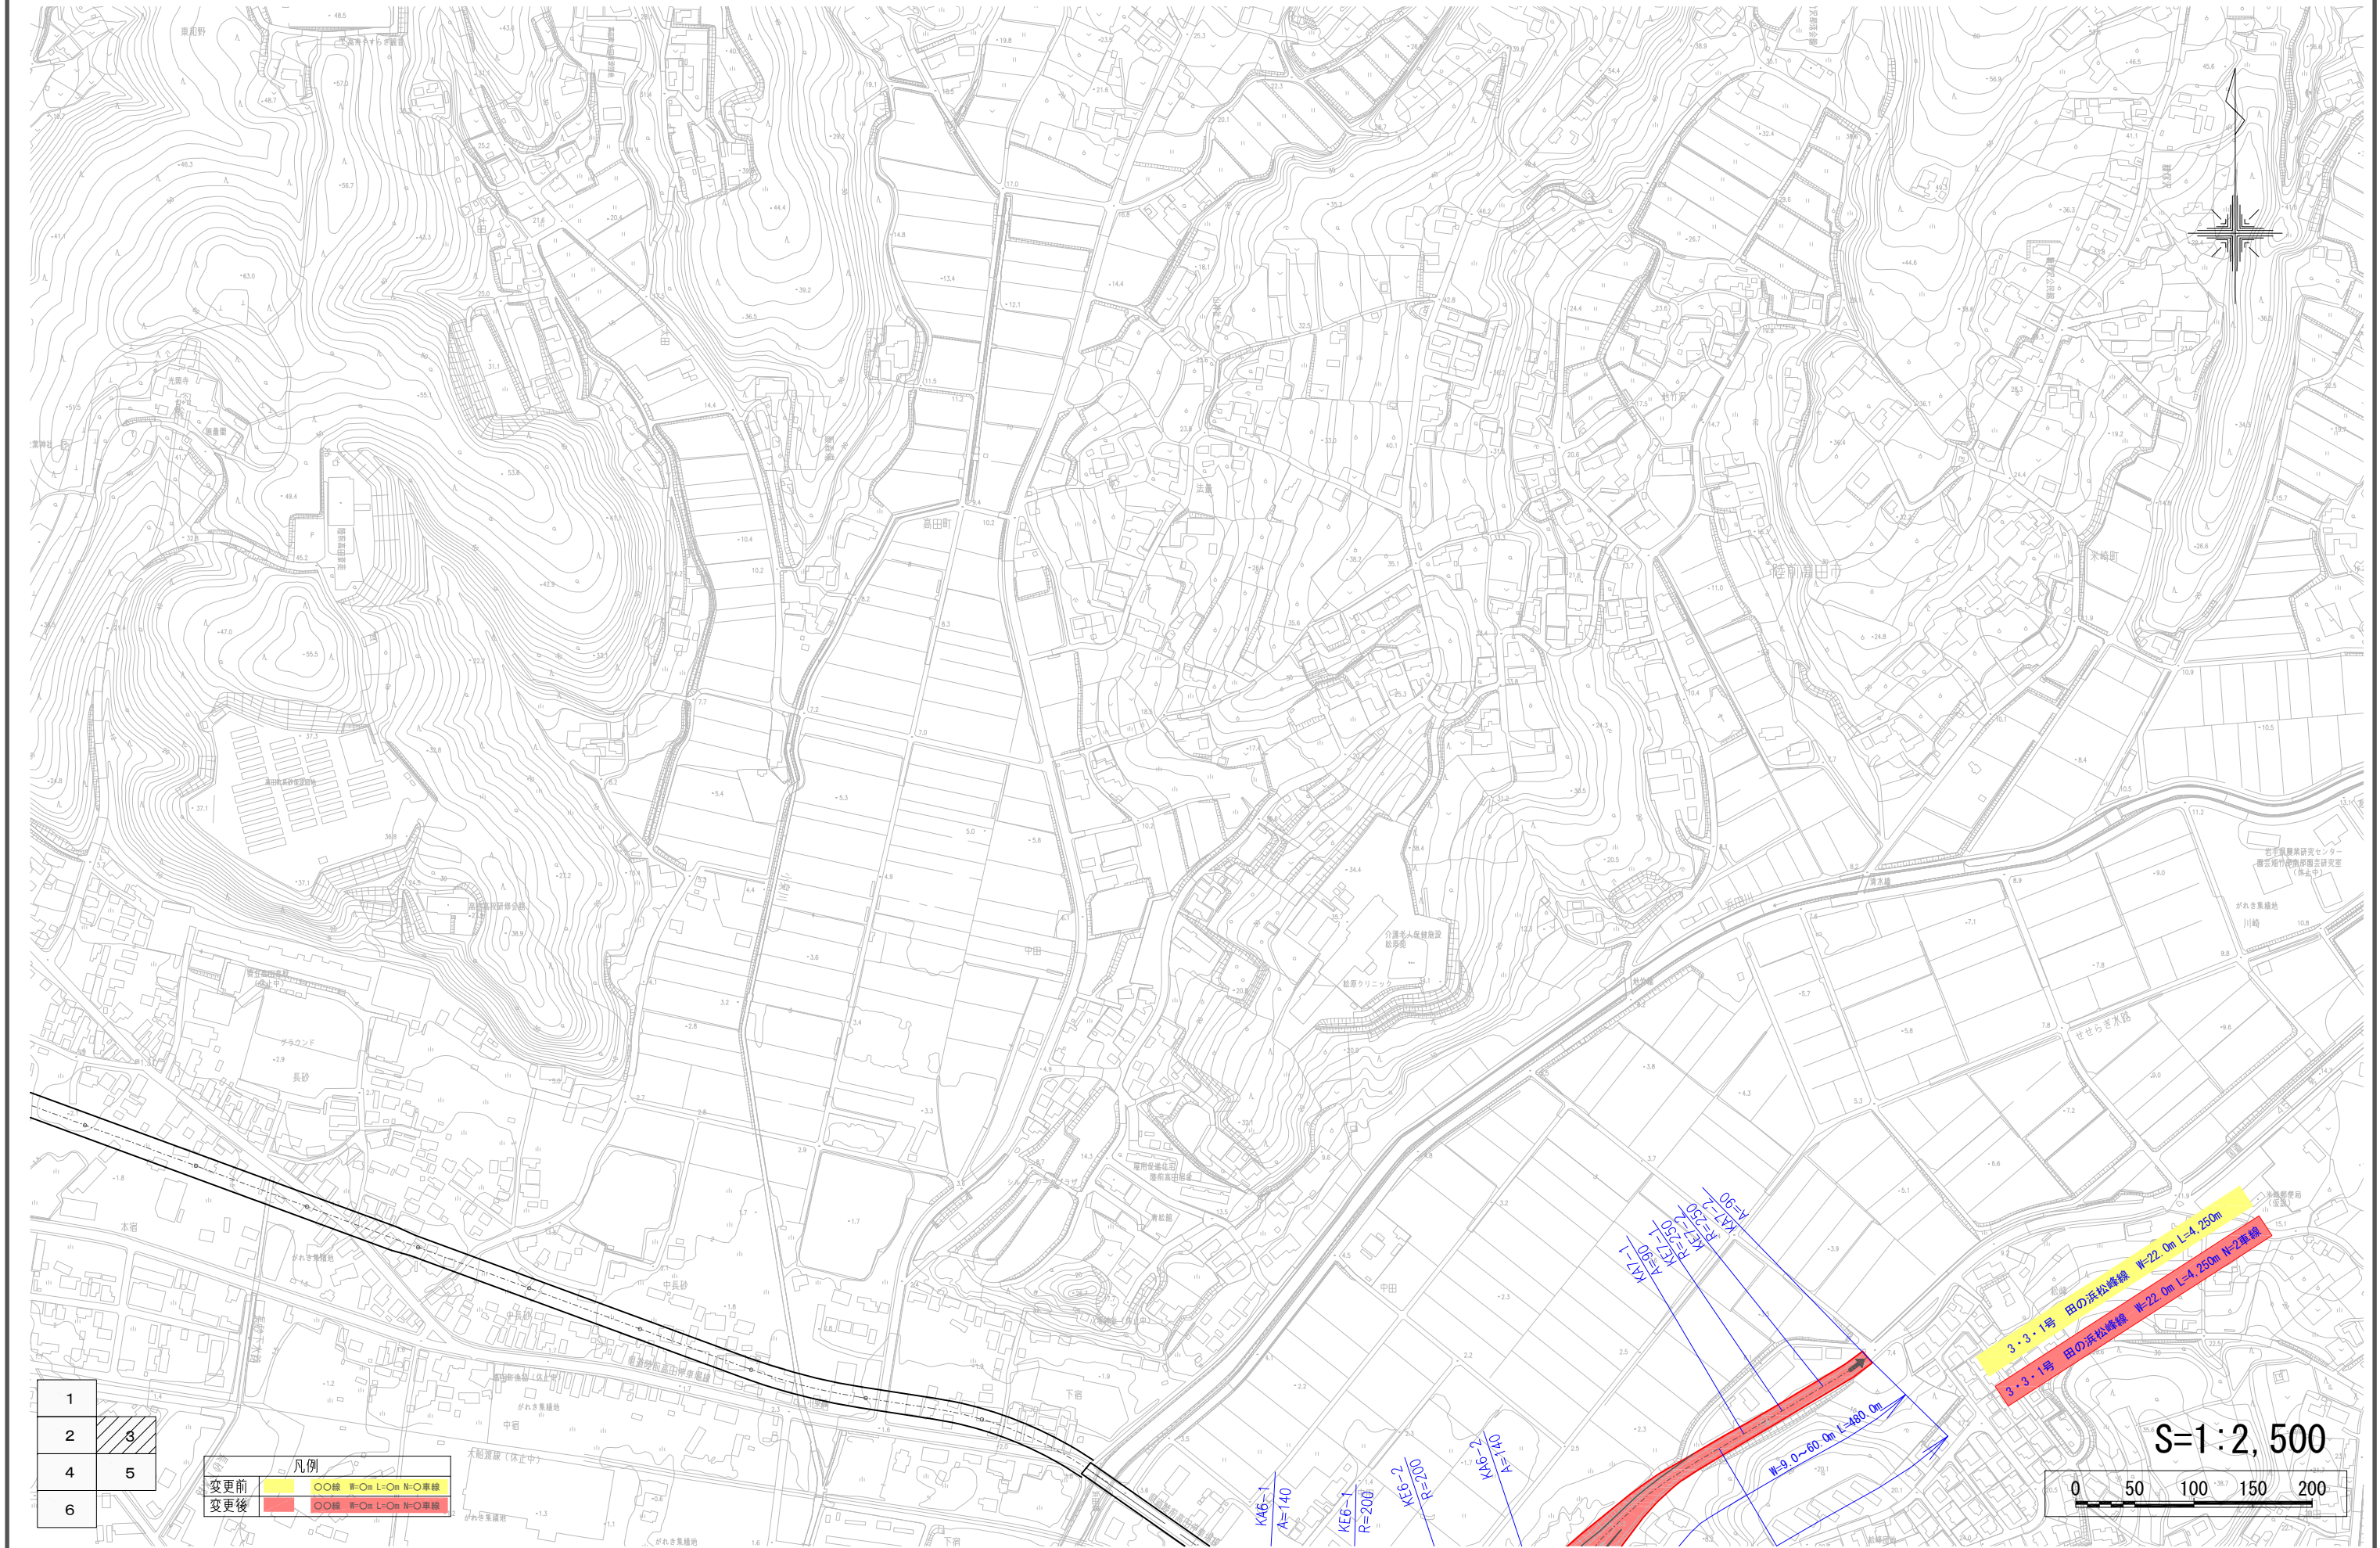


計画図(4) $S=1/2, 500$

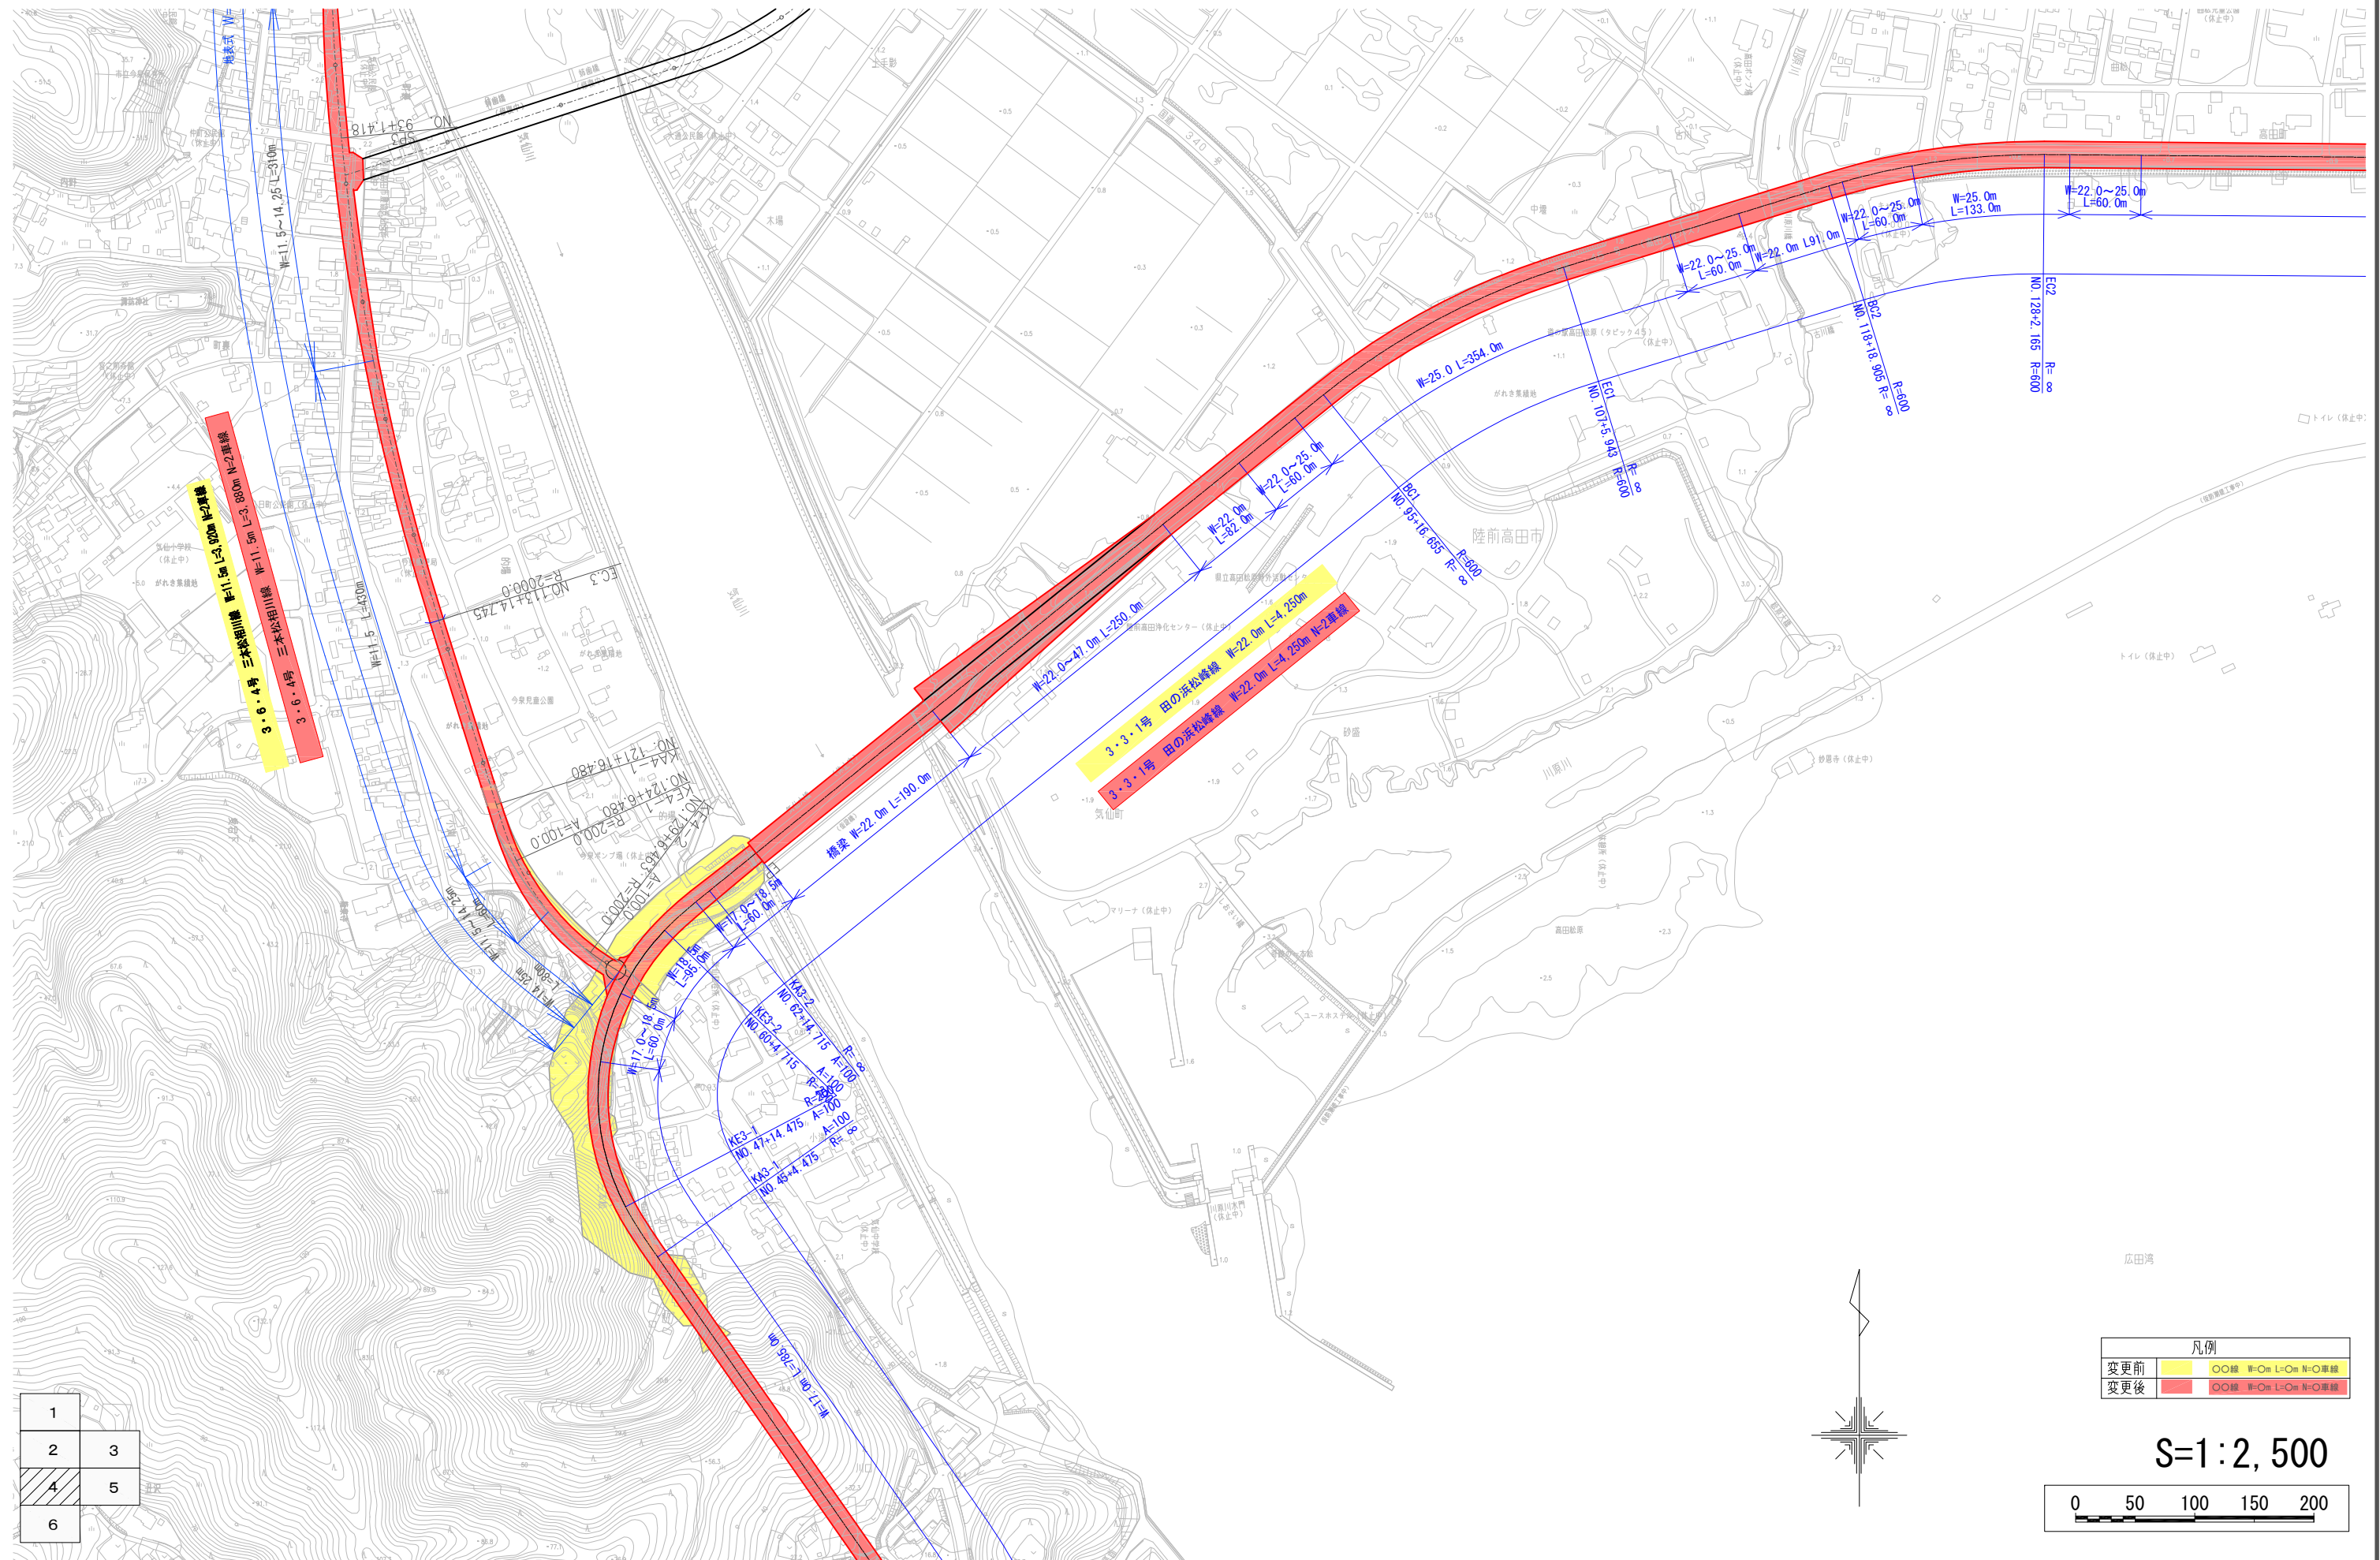

計画図(5) S=1/2, 500




1	
2	3
4	5
6	

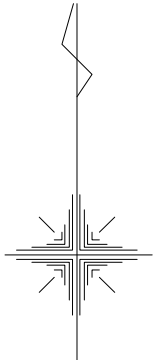

凡例	
変更前	〇〇線 〇〇m L=〇〇m N=〇車線
変更後	〇〇線 〇〇m L=〇〇m N=〇車線

S=1:2,500

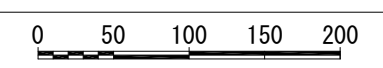

計画図(6) $S=1/2, 500$

