




計画図(1) S=1/2, 500

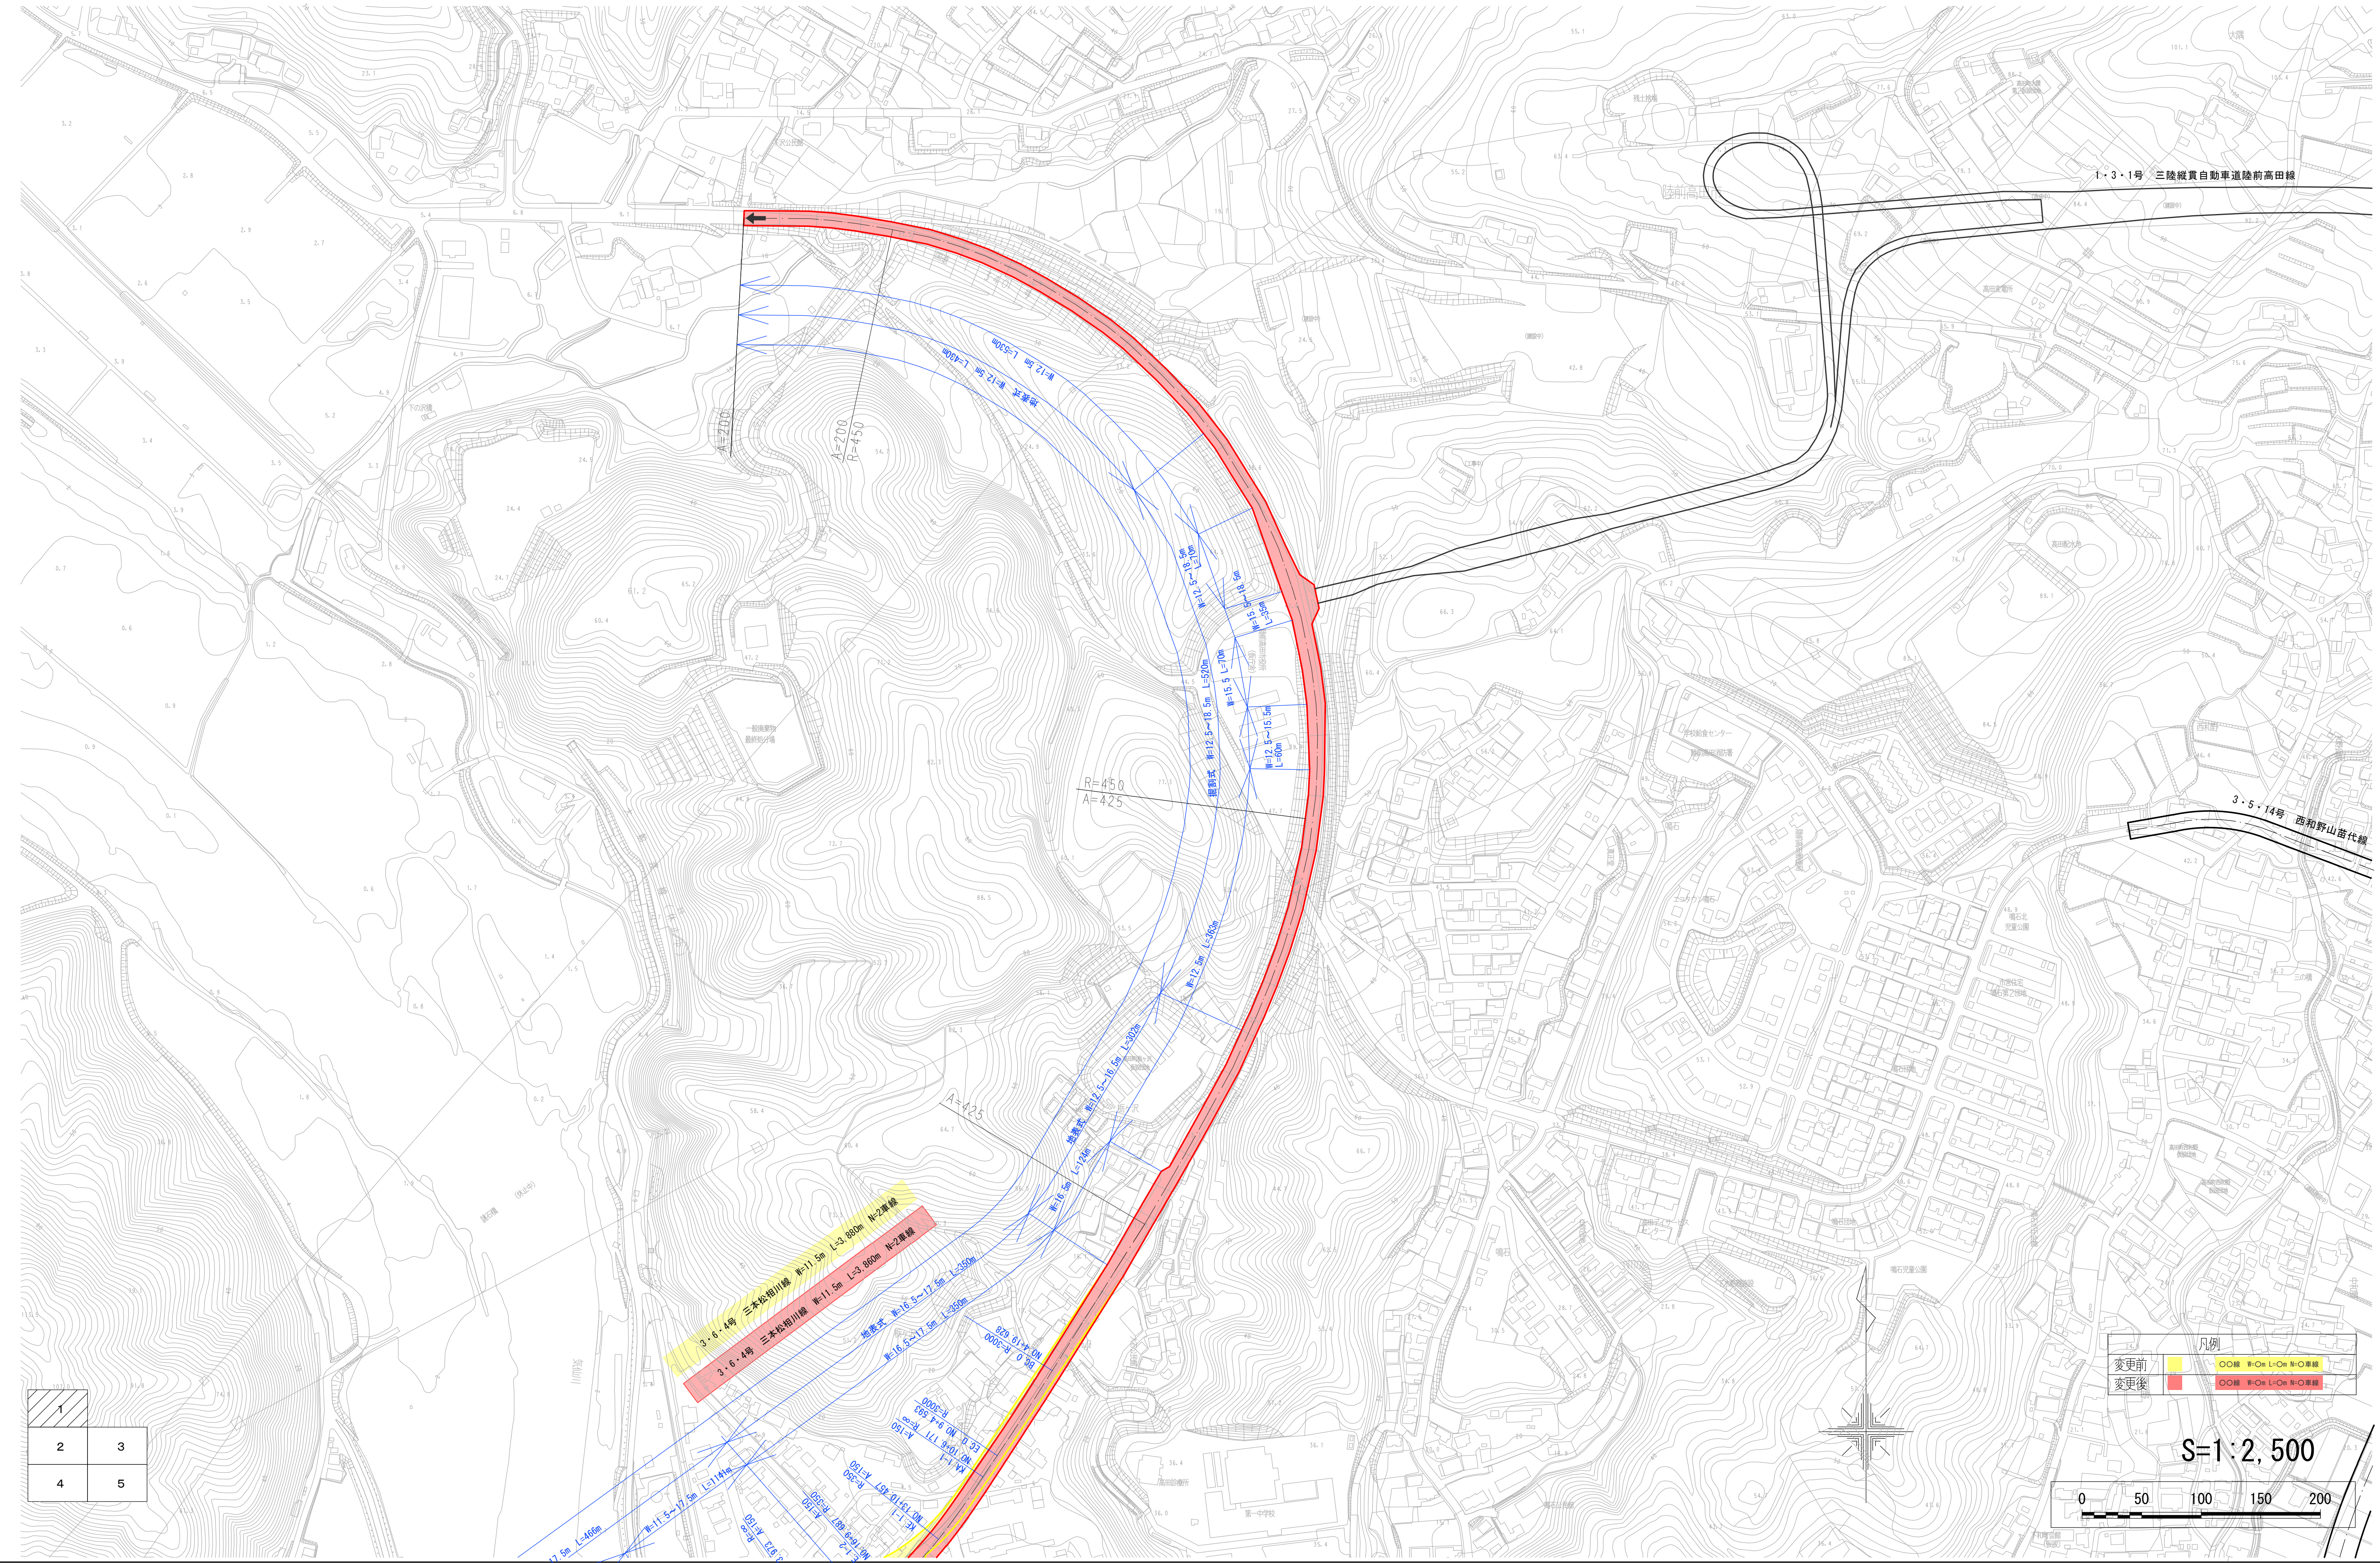


計画図(2) S=1/2, 500

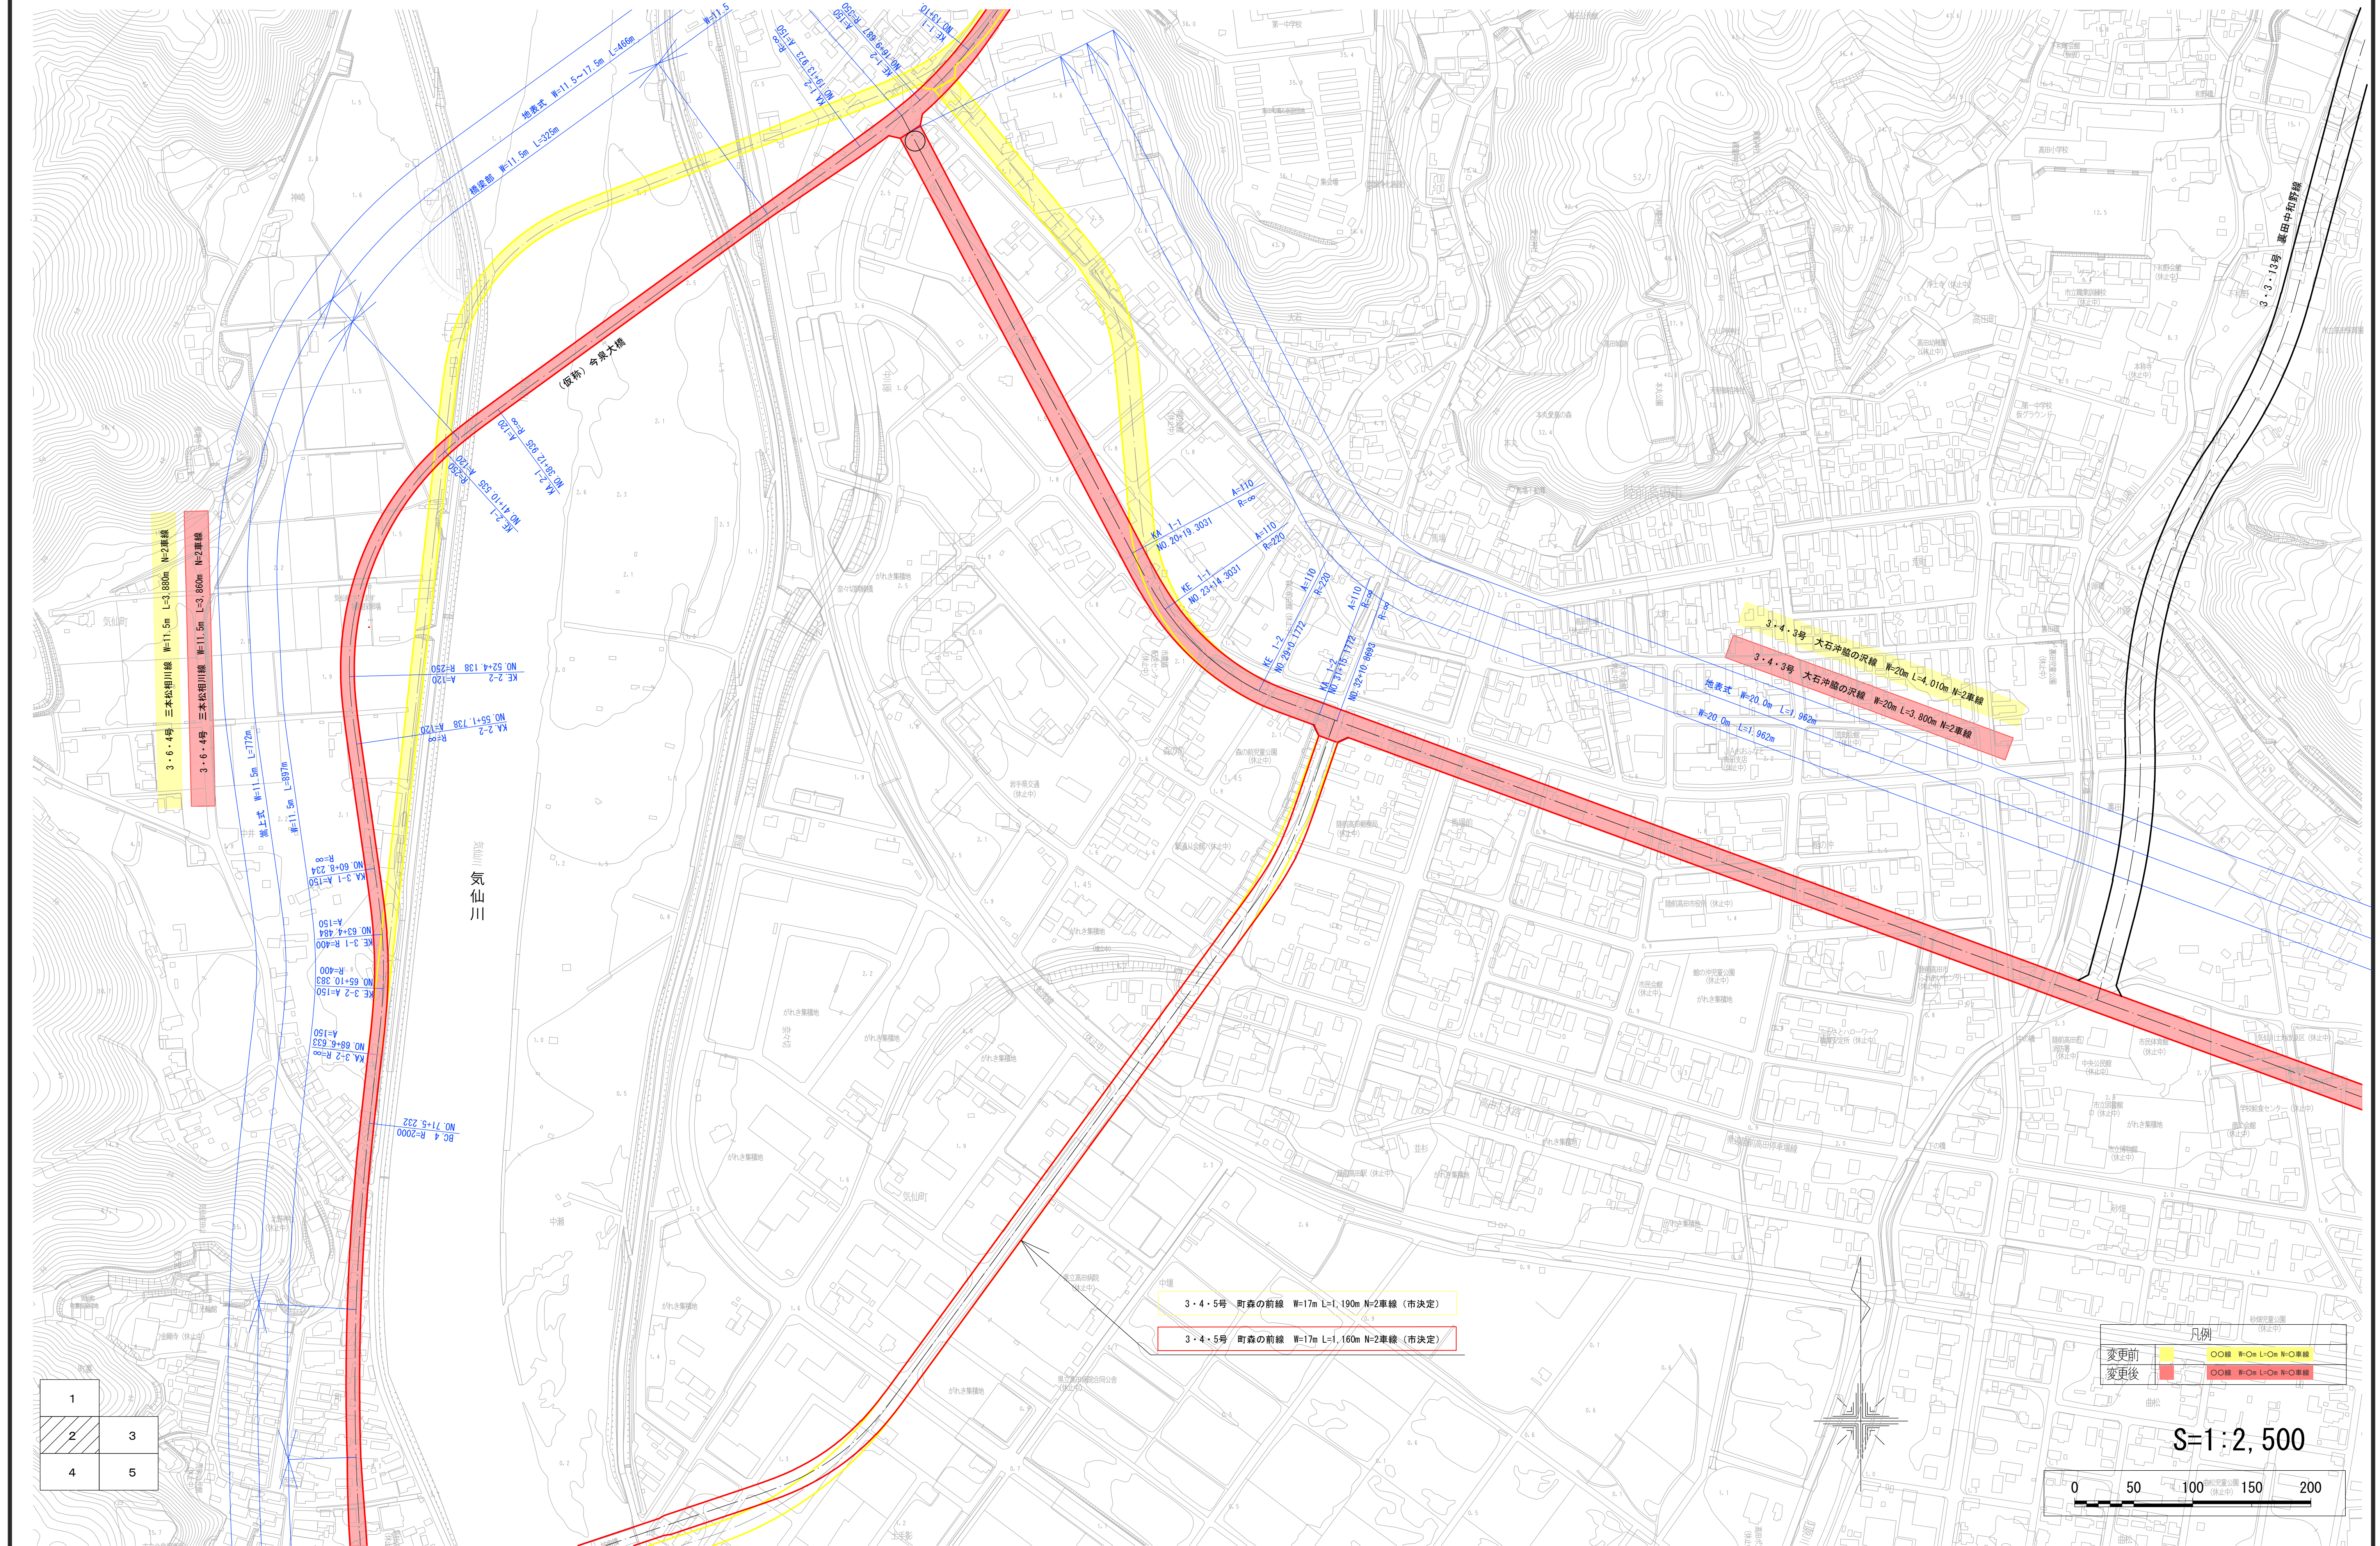

計画図(3) S=1/2,500

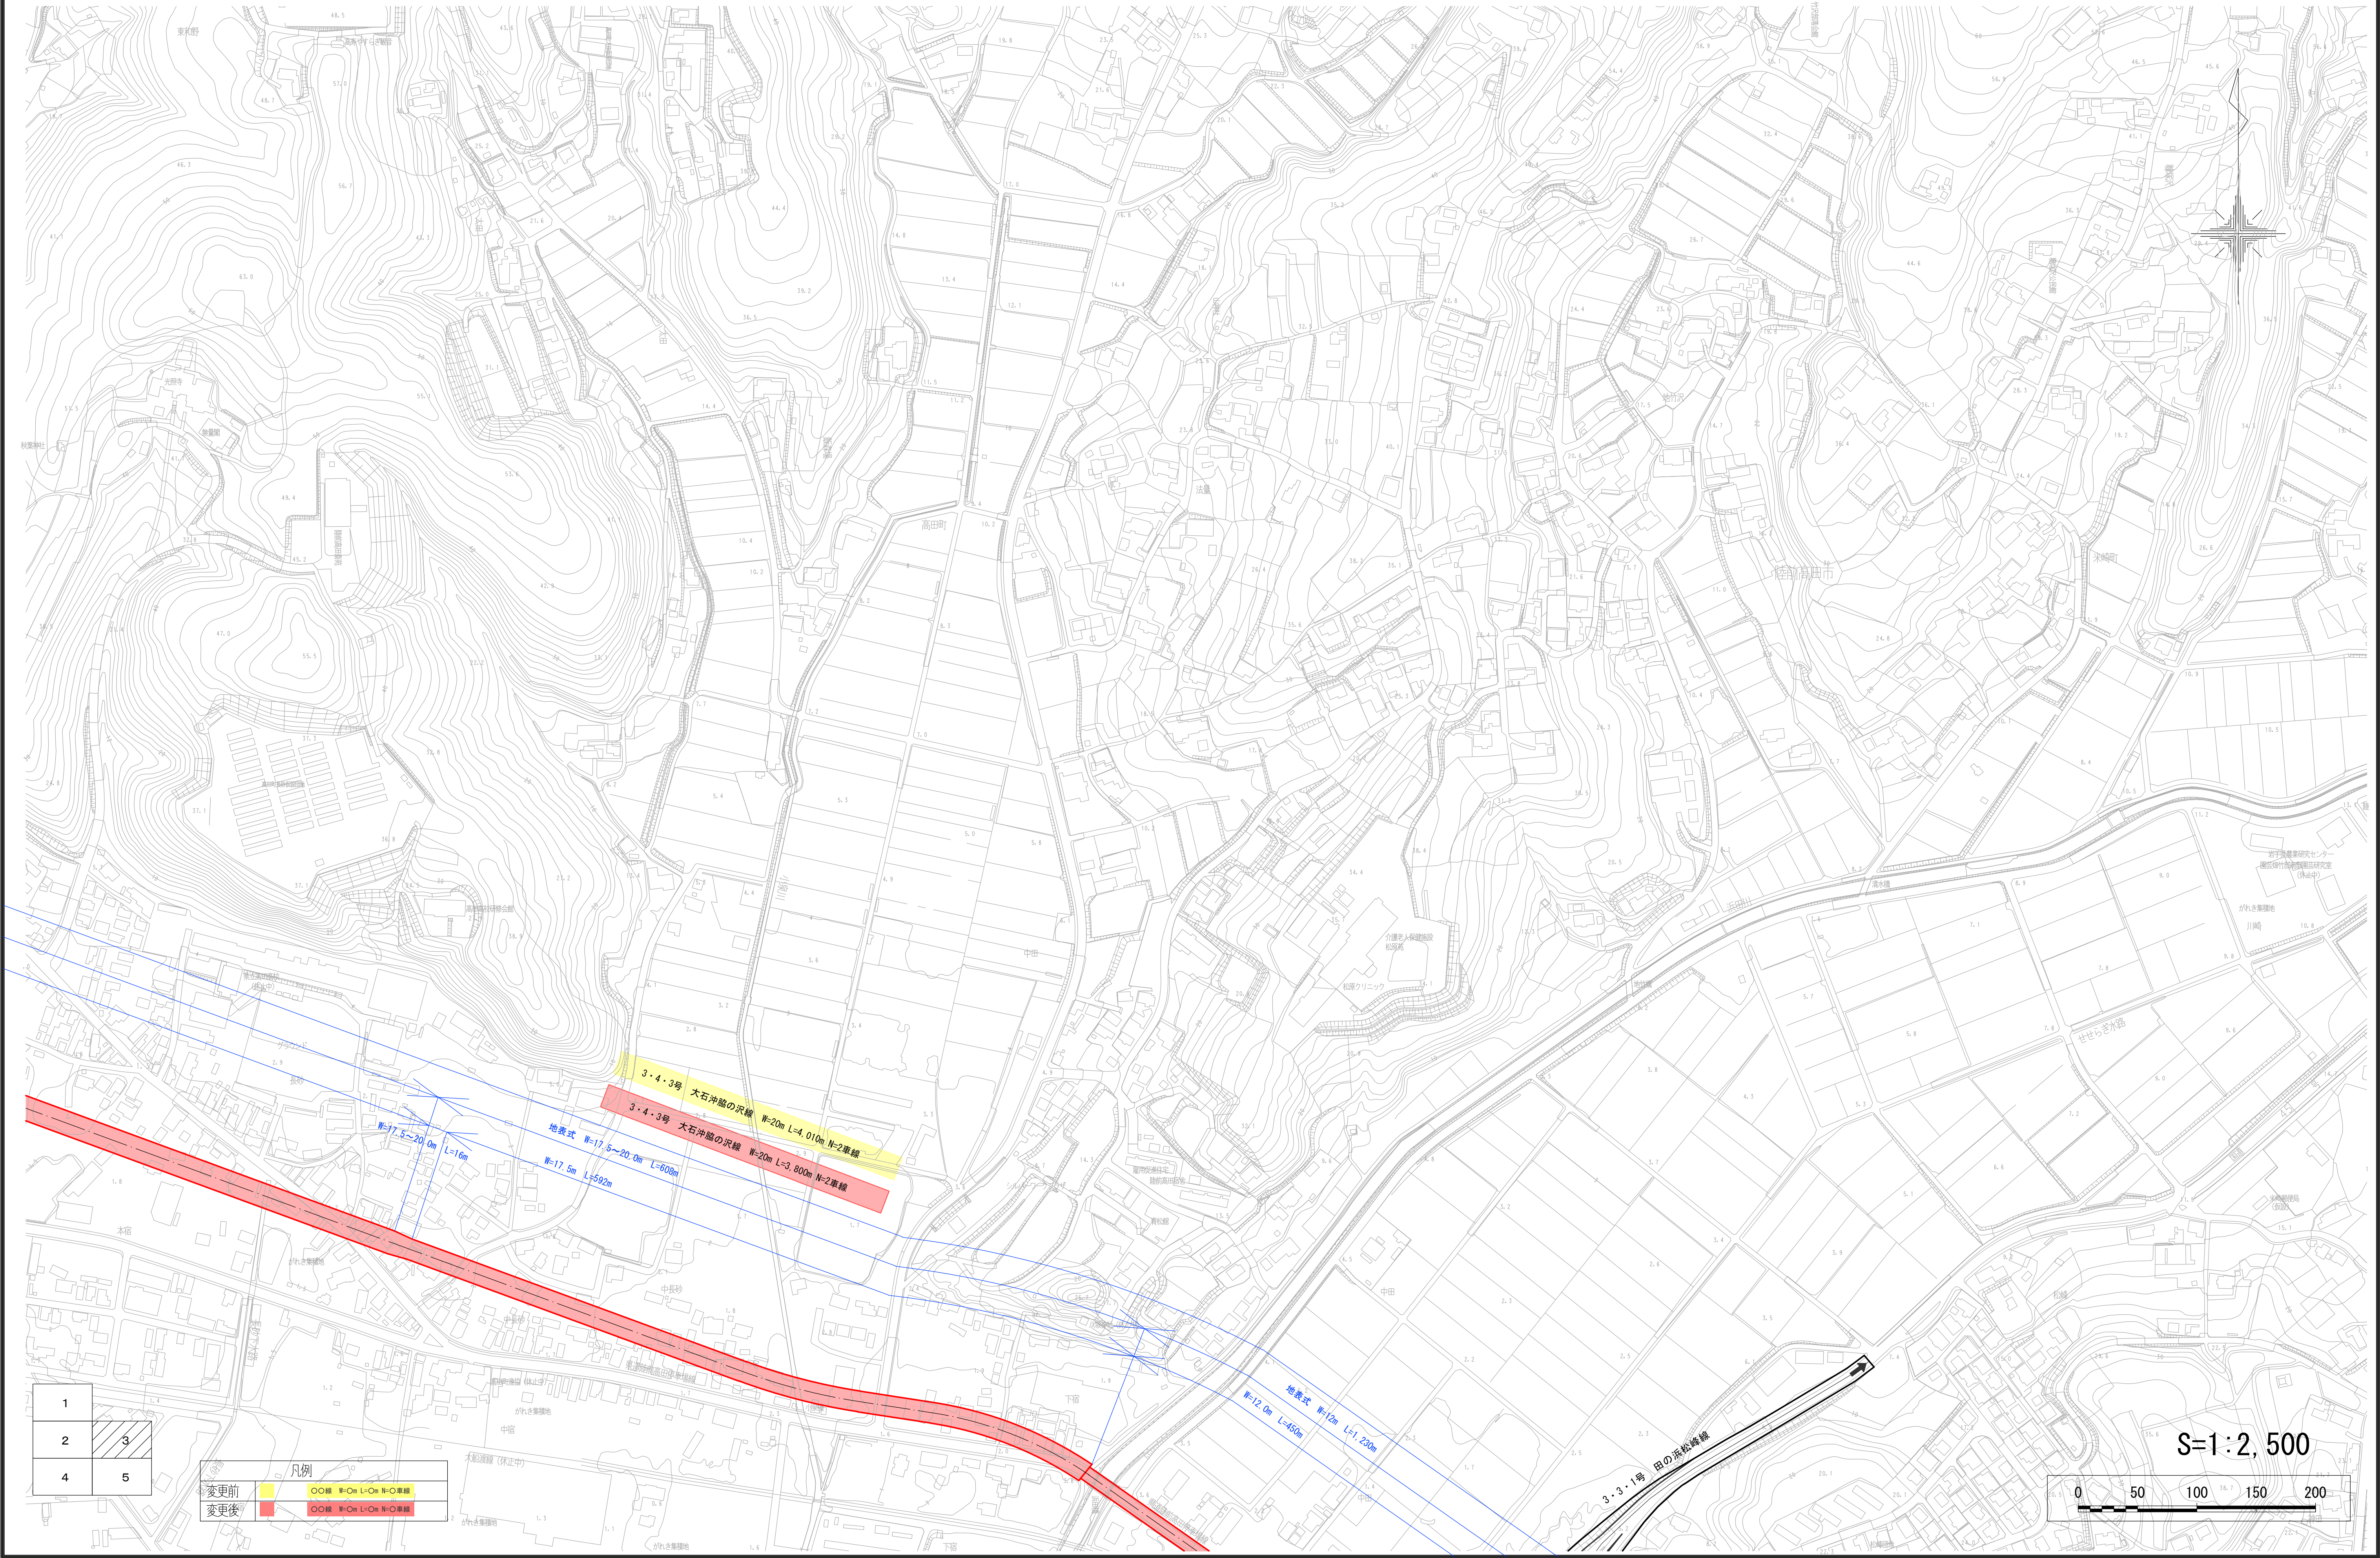

計画図(4) S=1/2, 500

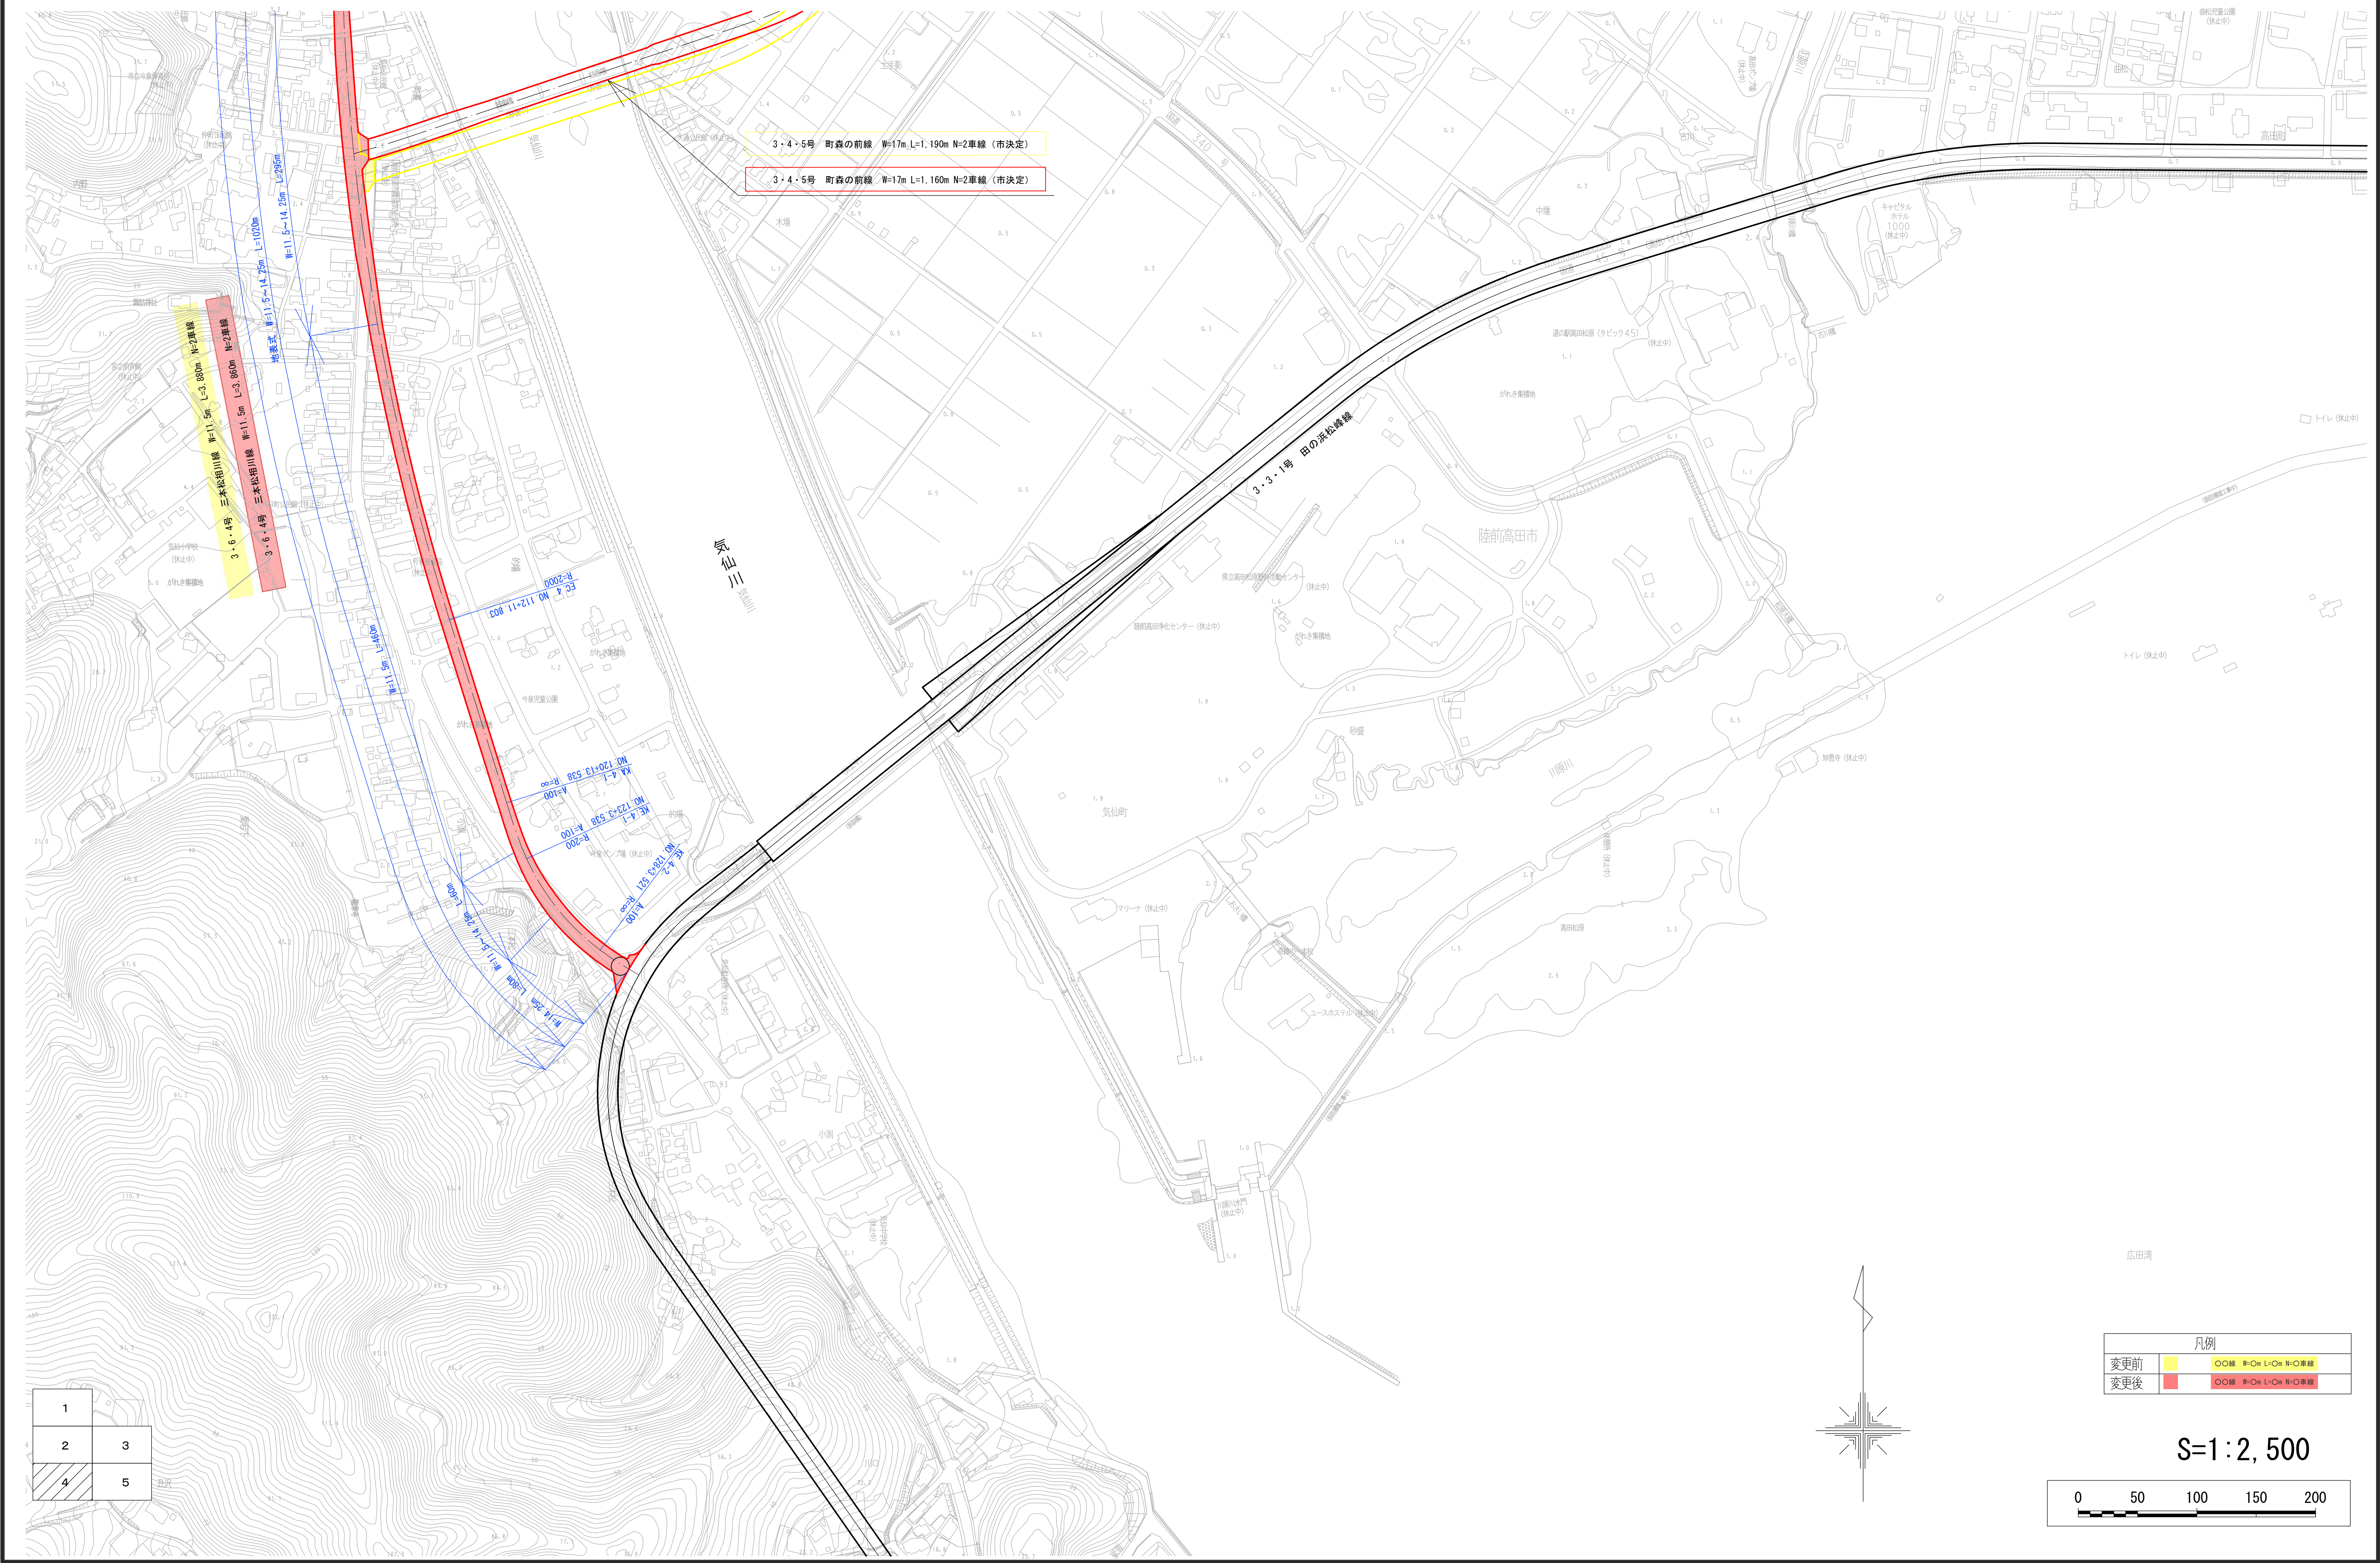

計画図 (5) $S=1/2, 500$

