



全体図

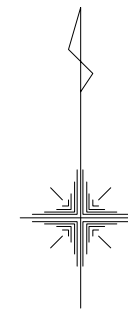


凡例	

S=1:10,000

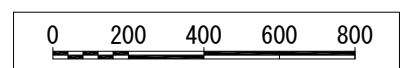


計画図(1) S=1/2, 500

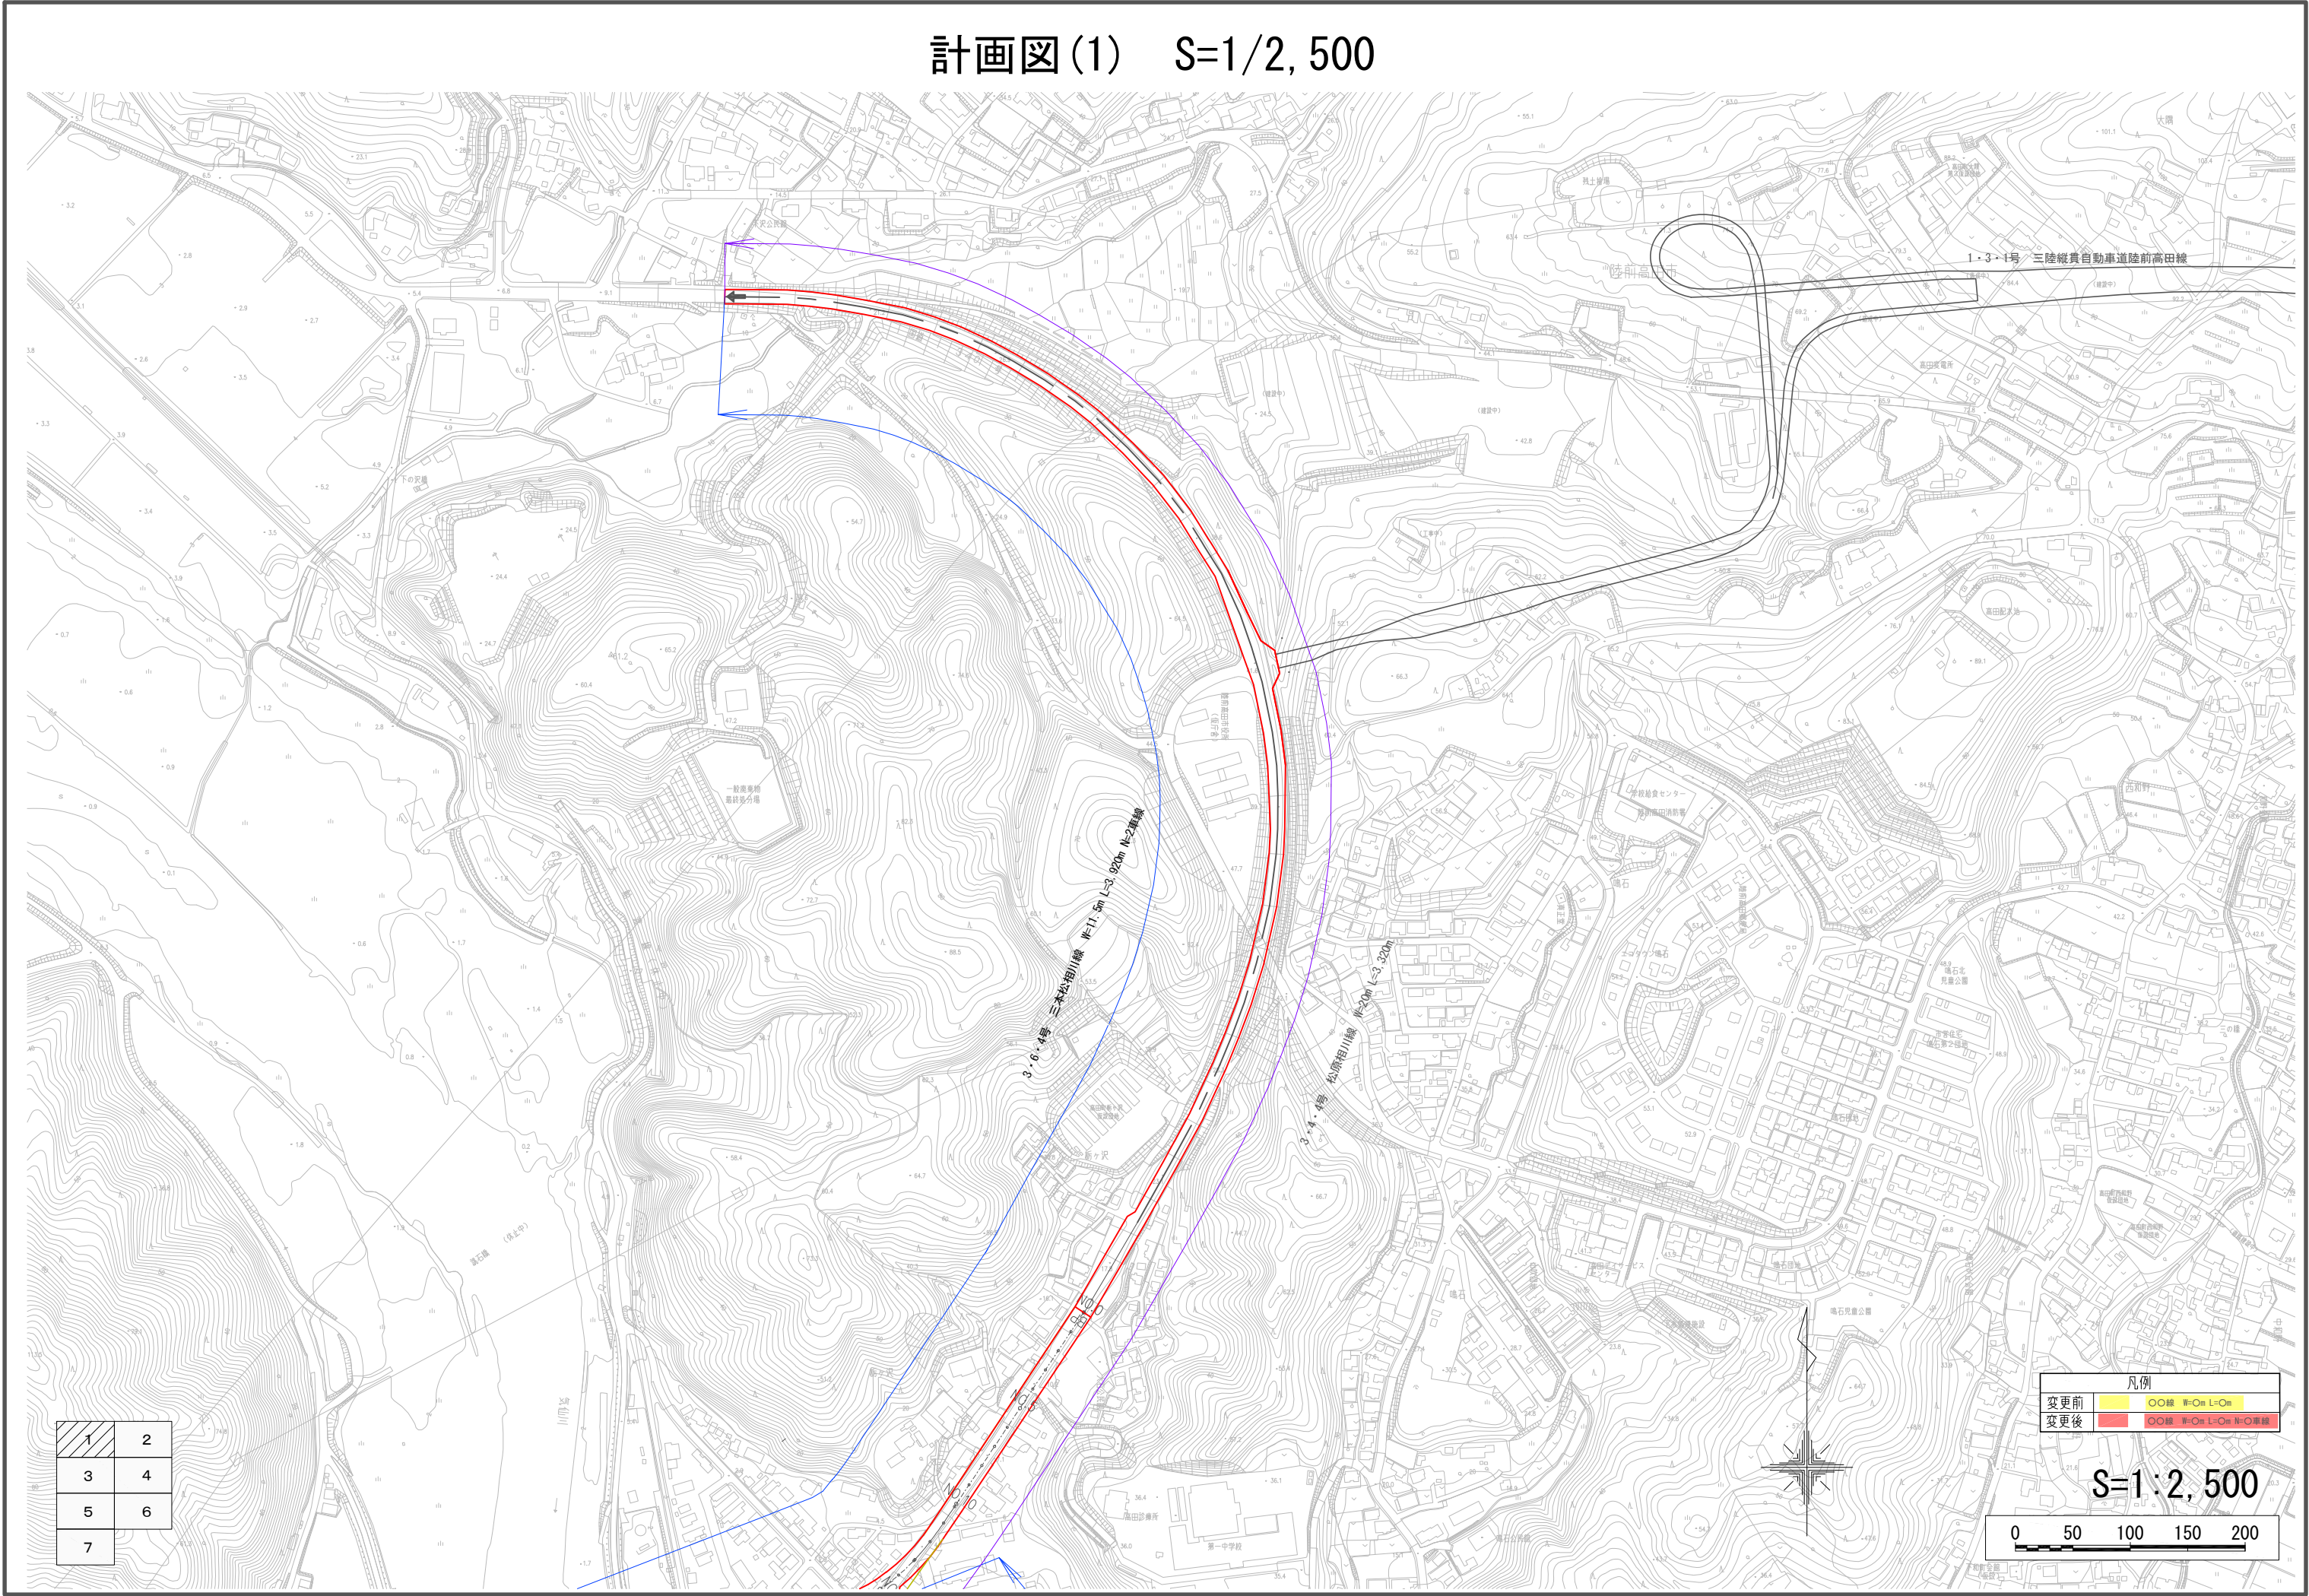


計画図(2) S=1/2, 500


計画図(3) S=1/2, 500

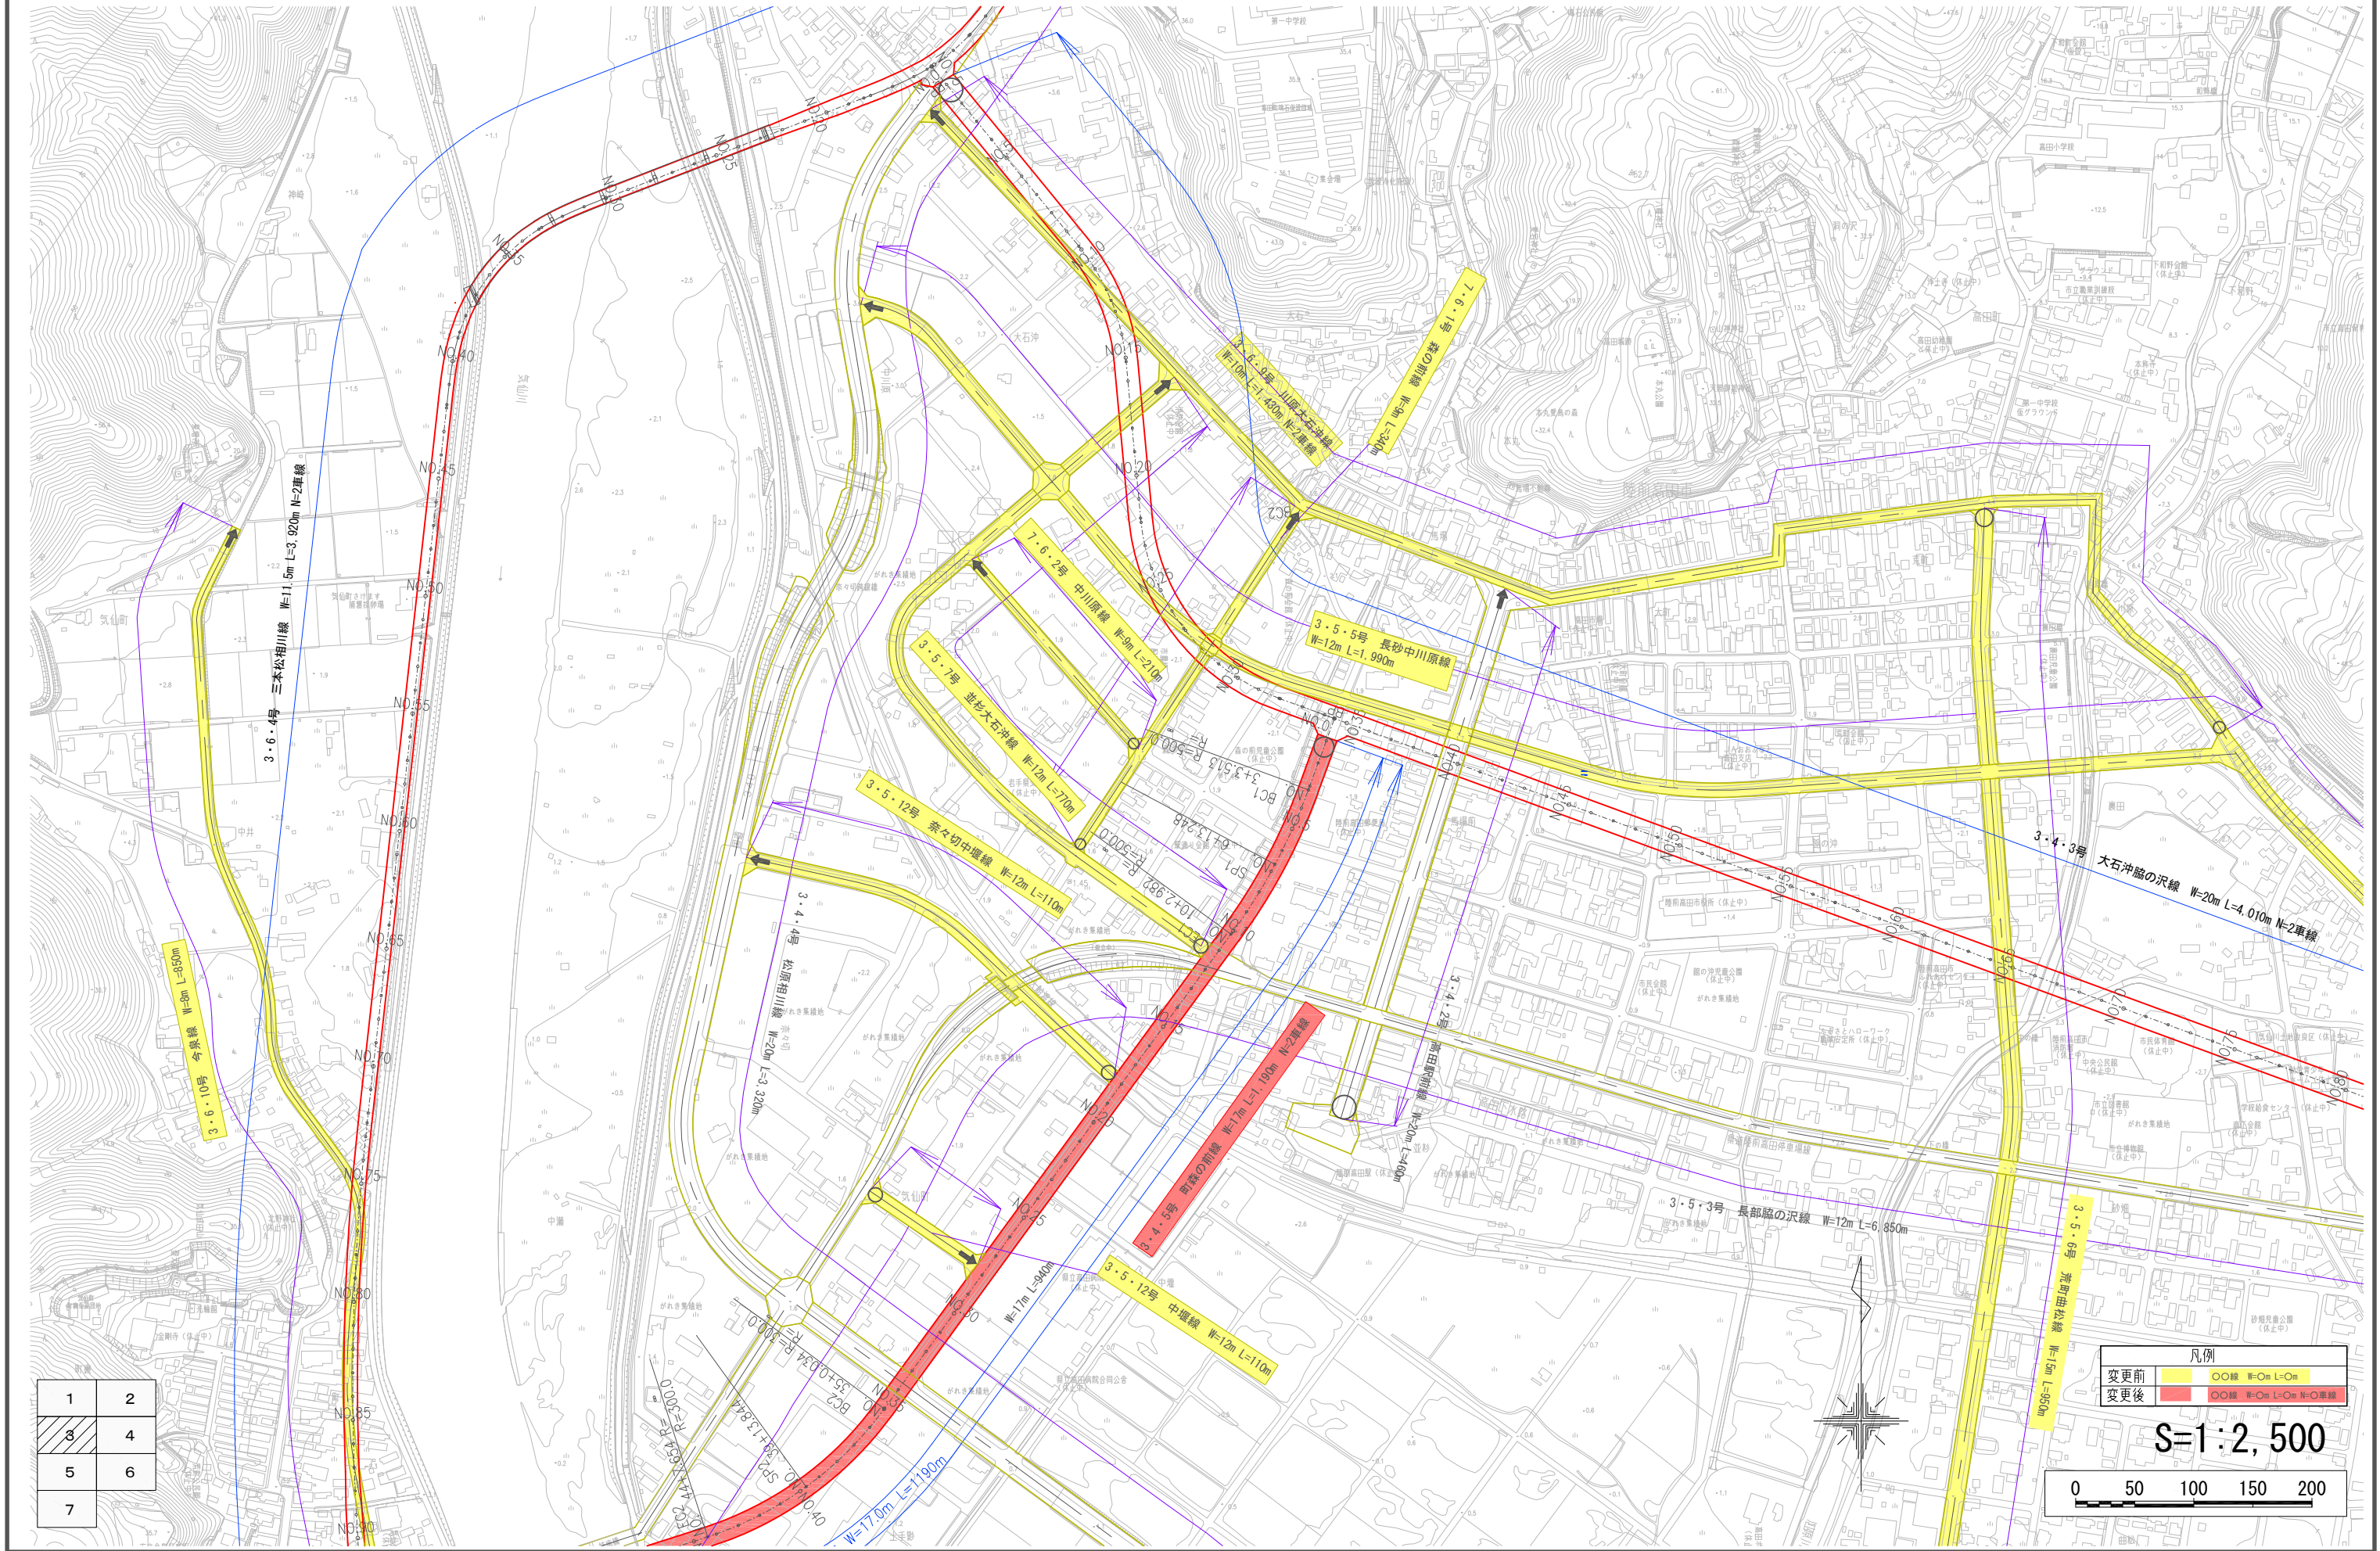


計画図(4) S=1/2, 500

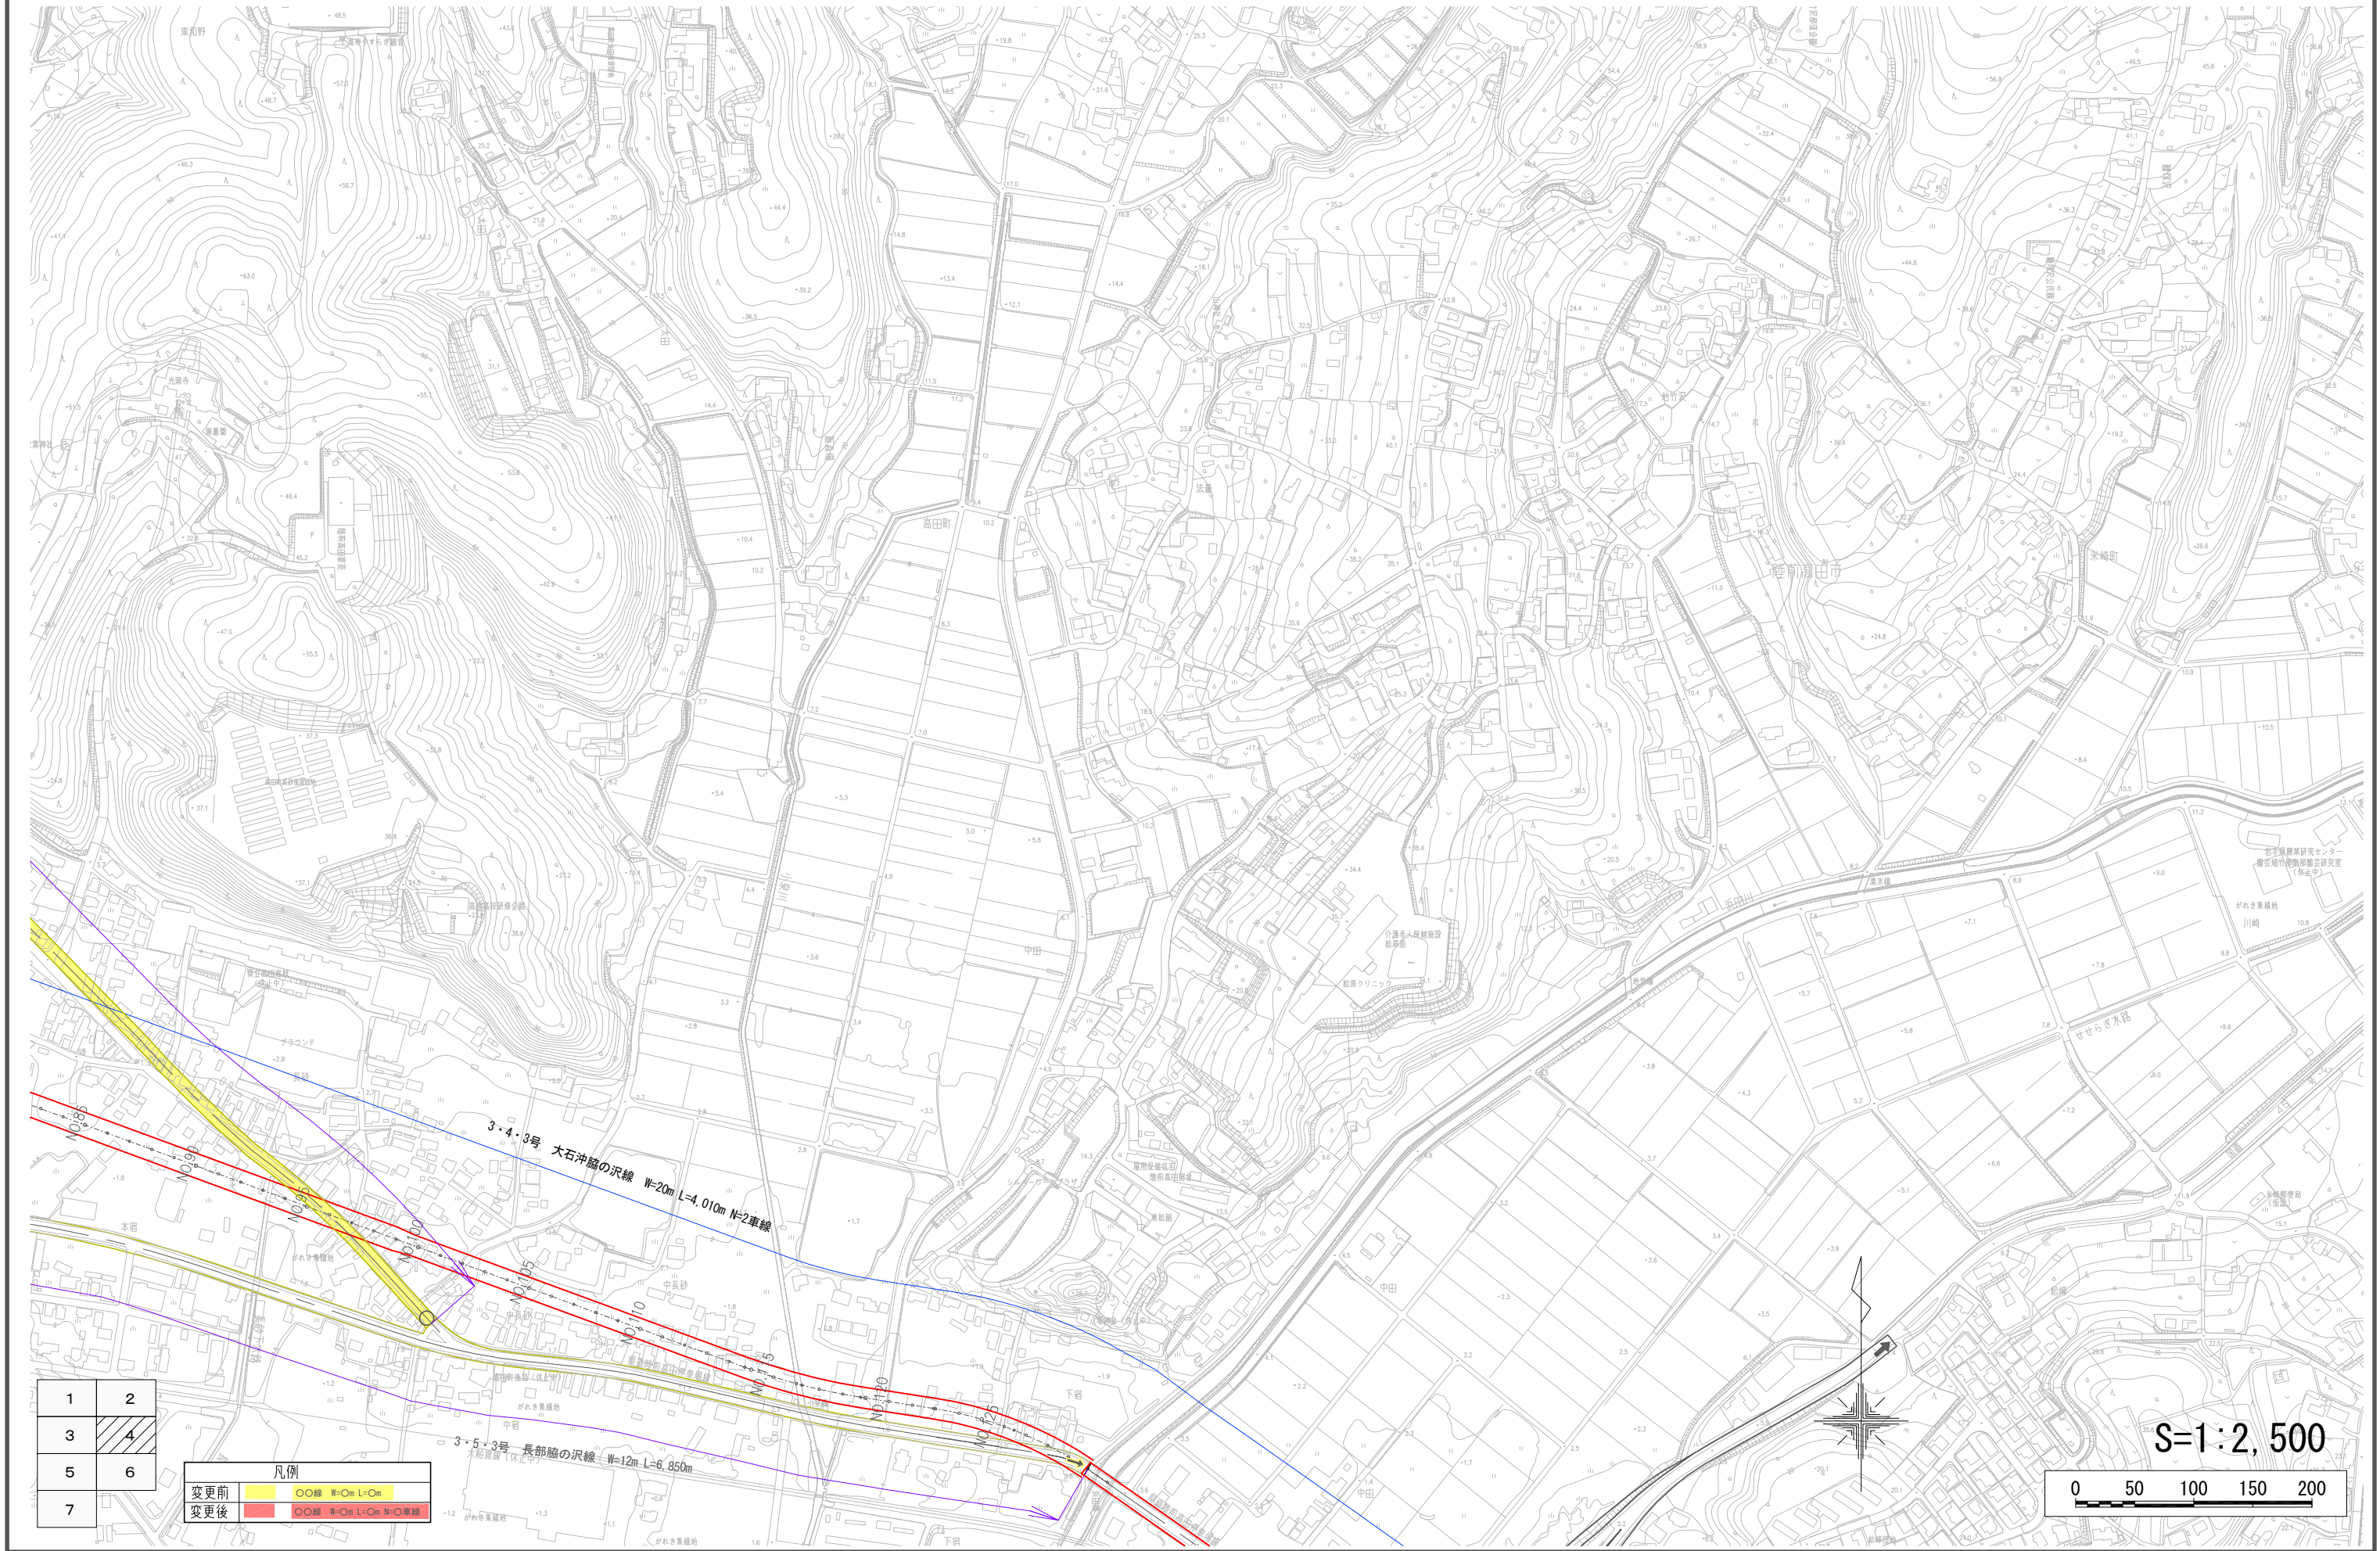

計画図(5) S=1/2, 500

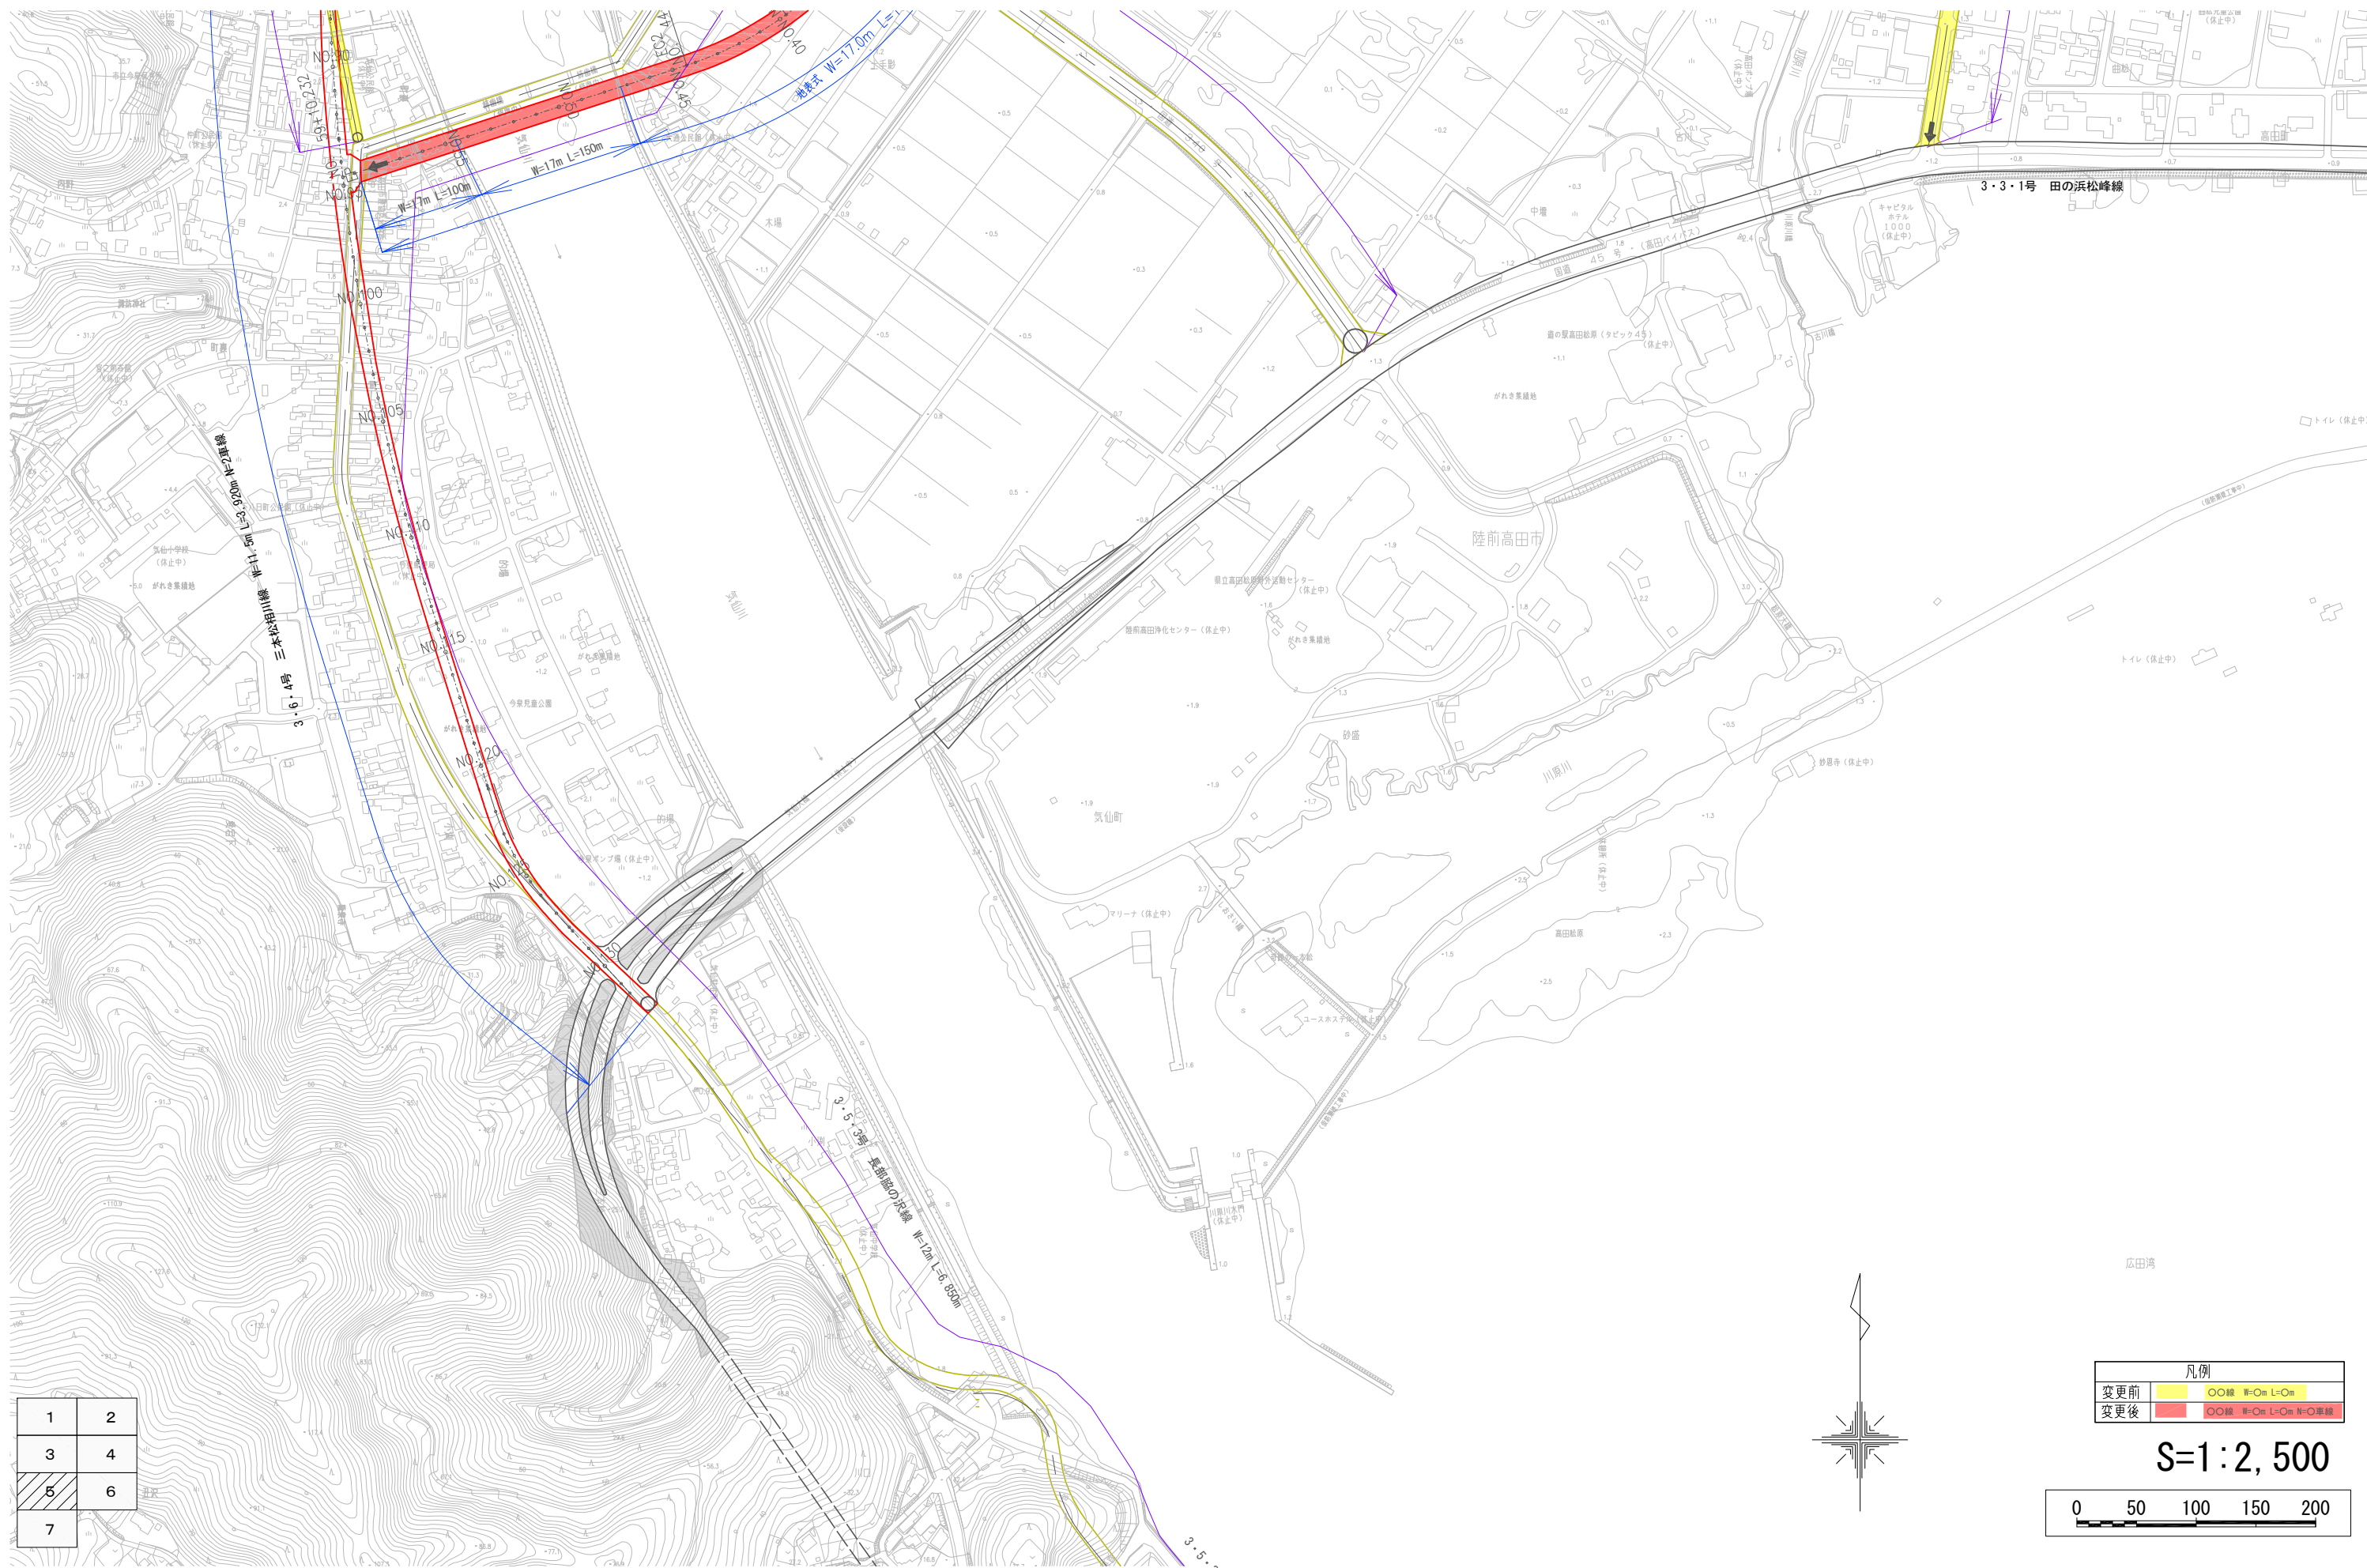

計画図(6) $S=1/2, 500$

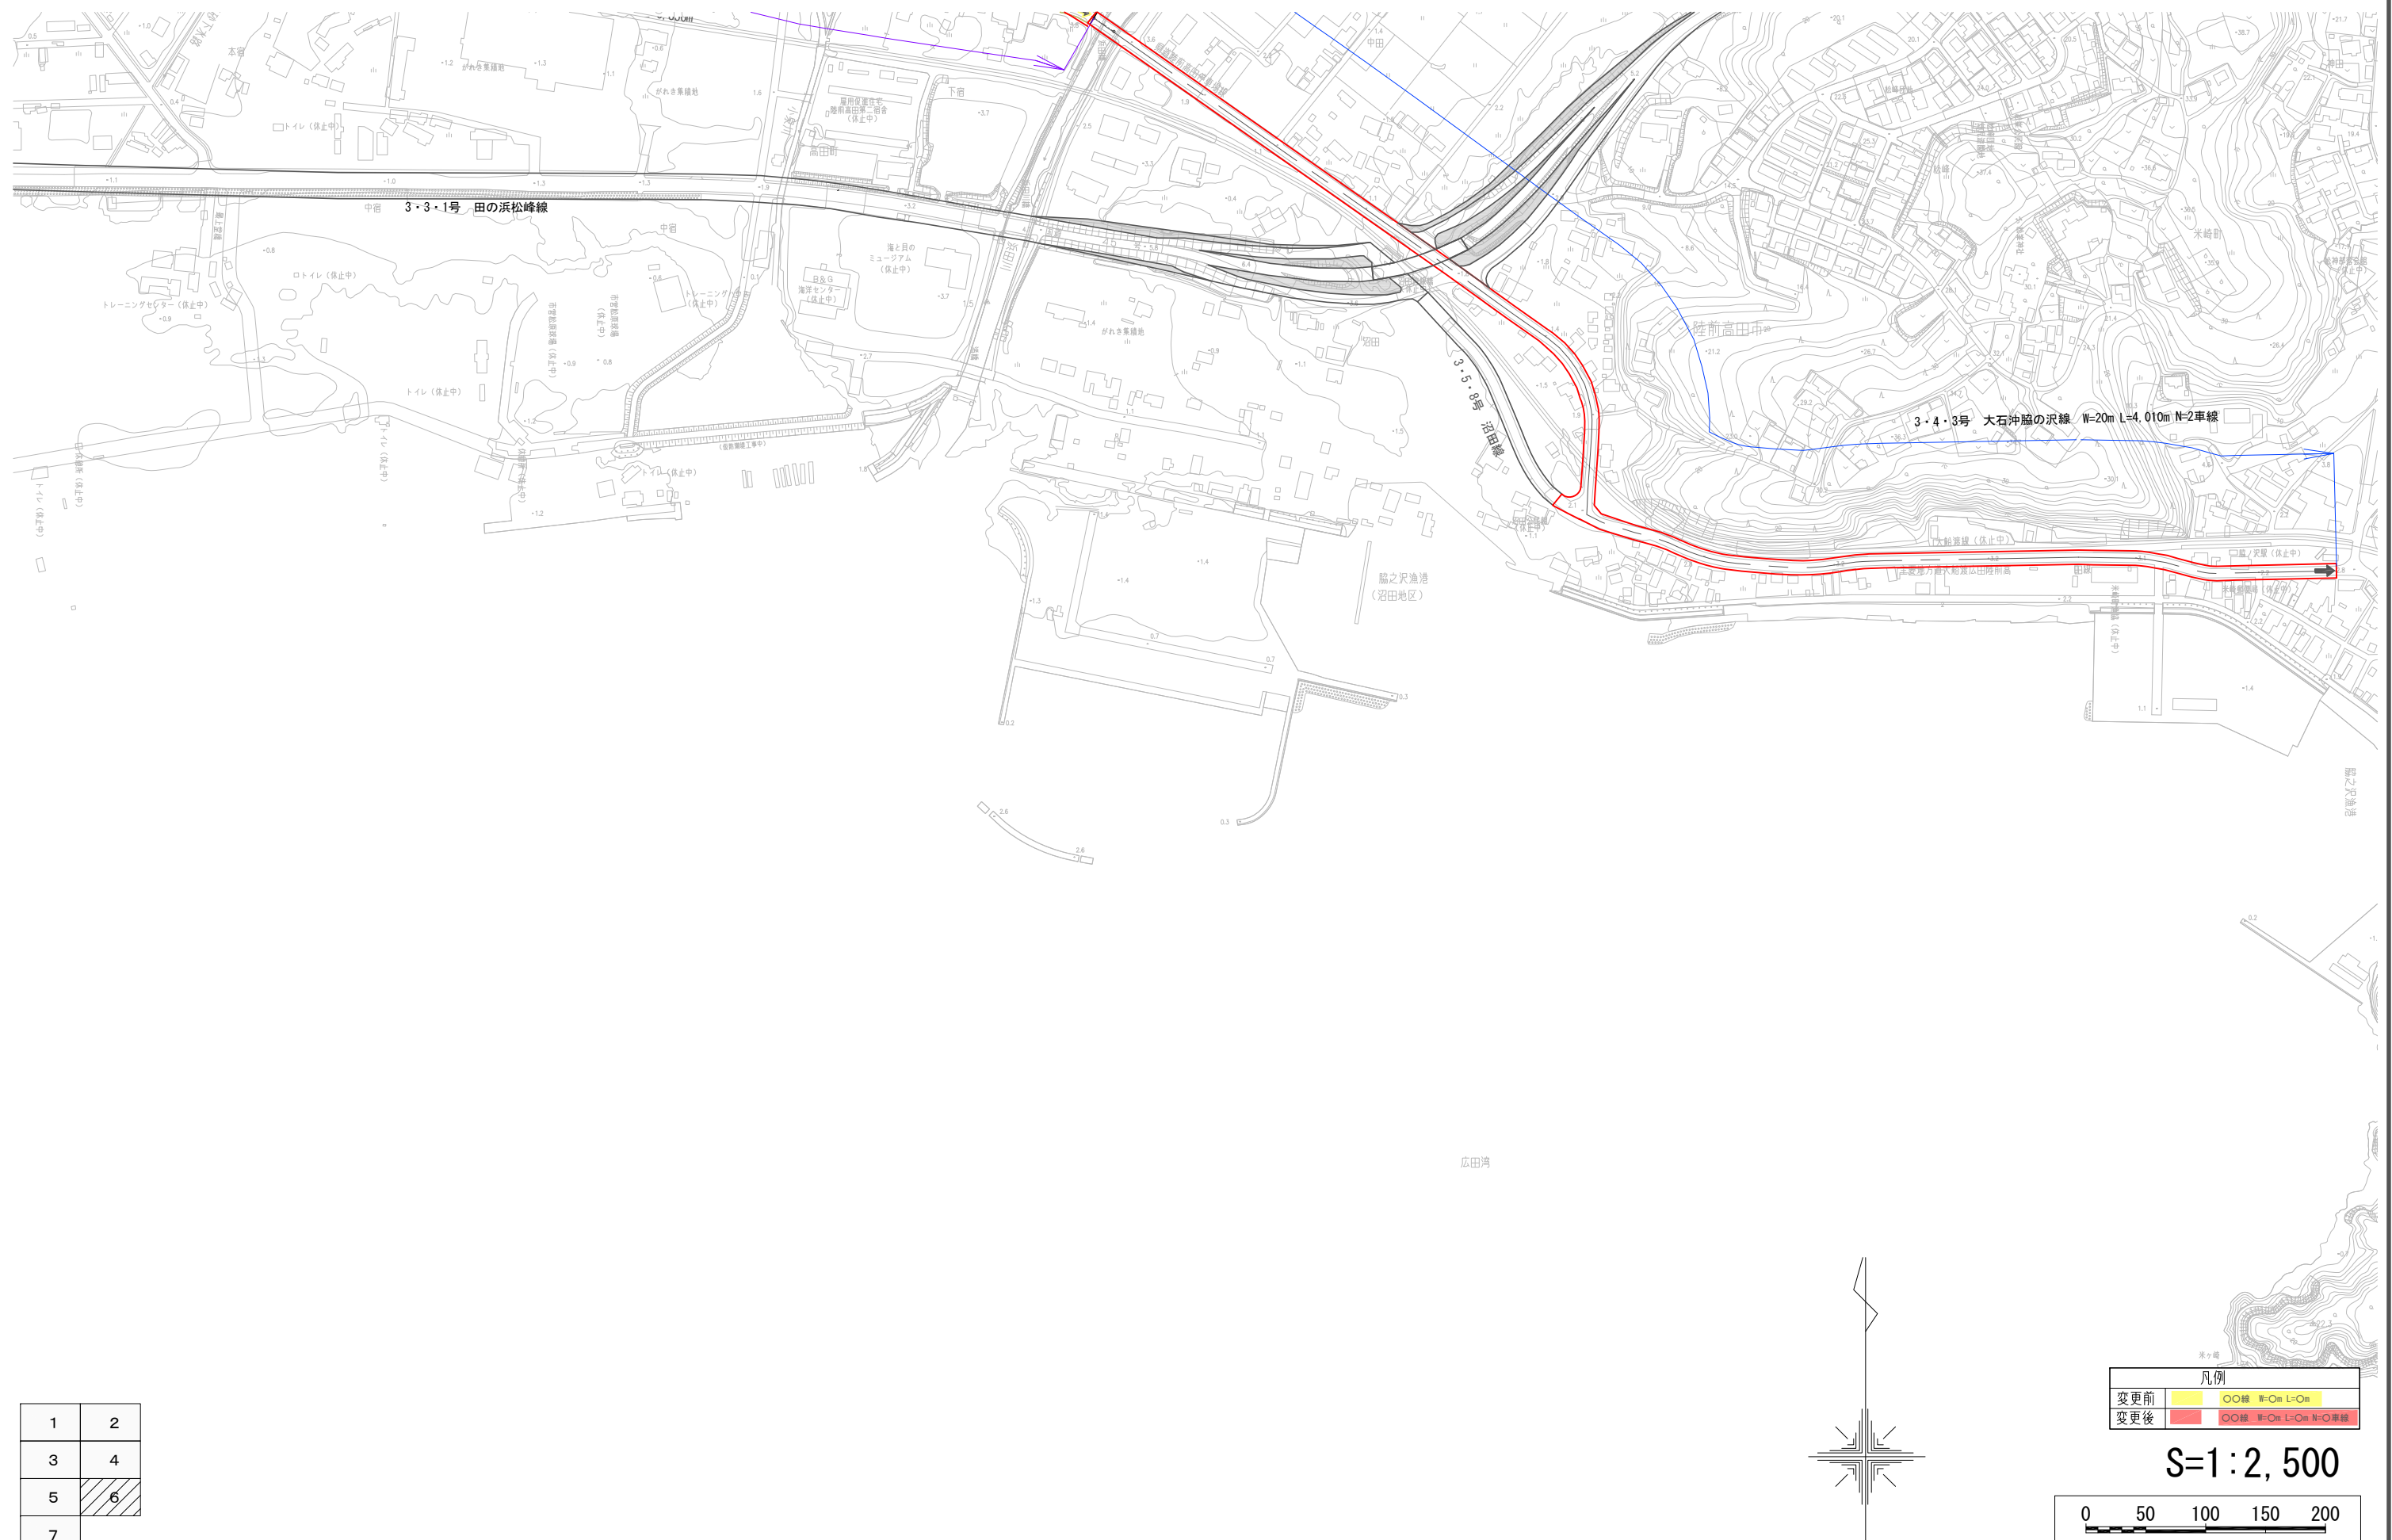

計画図(7) $S=1/2, 500$

